IREDELL COUNTY HEALTH DEPARTMENT

STATESVILLE 704-878-5305 MOORESVILLE 704-664-5281

IMPROVEMENT PERMIT / CERTIFICATE OF COMPLETION / OPERATION PERMIT / EXISTING SYSTEM INSPECTION

PROPERTY DESCRIPTION NO. REPAIR DATE 5/24/95 TAX MAP NO. Watershed: ☐ Yes ☒ No

OWNER OR CONTRACTOR ROY GAITHER, SR PHONE: Business 546-7825 Home 546-7518

ADDRESS #1053 E. MEMORIAL HWY, HARMONY, NC 28634

LOCATION US 21 N, TR NC 901, 1ST BRICK HOUSE ON LEFT ~ 3/4 MILE PAST GUILFORD RD

SUBDIVISION BLOCK / SECTION LOT LOT AREA 300 ACRES SITE CLASS. P3 DESIGN FLOW 360 L.T.A.R. EXISTING

Septic Tank: EXISTING Gallons; STB Date

Pump Tank: Gallons; PT Date

Pump Make: Model Serial No.

Nitrification Field: No Fields 1 Square Feet 600 Linear Feet 100

No Lines 1 BED Trench Width 72" Max Trench Bottom Depth 36" Gravel Depth 12"

☐ New System ☒ Repair System Type: I, II, III, IV, V, VI

System Description: CONV. GRAVITY

Repair System Description: 6' BED GRAVITY

Maintenance Agreement Required: ☐ Yes ☒ No

☒ House/Mod. Home No. Bedrooms 3

☐ Mobile Home No. Bathrooms 2

☐ Business No. Employees

☐ Other


☐ Slab ☐ Crawl Space ☒ Basement w/plumbing ☐ Basement wo/plumbing

Water Supply: ☒ Individual ☐ Community ☐ Public WELL

Comments: ① PUMP-OUT SEPTIC TANK, CHECK SANITARY TEE, REPLACE IF NECESSARY ② INSTALL NEW 6' WIDE BED AS SHOWN USING 12" STONE

Comments: ① SYSTEM PUMPED OUT 6/12/95 ② NEW SANITARY TEE INSTALLED IN SEPTIC TANK

INITIAL SITE SKETCH

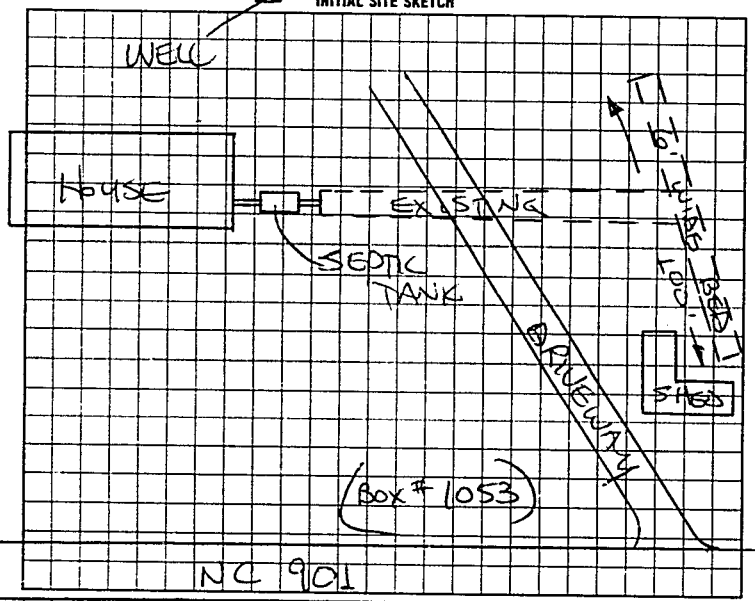

AS BUILT SKETCH

SYSTEM REPAIRED ACCORDING TO INITIAL SITE SKETCH

I understand that this permit can be suspended or revoked if any false information is supplied toward securing the permit/any unauthorized changes are made to the site/any unauthorized changes are made in the installation of the system. Improvement Permit is valid for 60 months from date of issuance.

Signed: Roy Gaither

Improvement Permit by: STEVE HENDRICK date 5/24/95

Existing System Inspection by: date

Installed by: SAMMY REAULS

Certificate of Completion by: STEVE HENDRICK date 6/13/95

Operation Permit by: date

HEALTH DEPT. COPY: WHITE INSPECTION COPY (FINAL): GREEN OWNER COPY (FINAL): YELLOW INSPECTION COPY (INITIAL): PINK OWNER COPY (INITIAL): GOLD

000310