Whitcomb, Karen A Pt 19

IREDELL COUNTY HEALTH DEPARTMENT

STATESVILLE 704-878-5305 MOORESVILLE 704-664-5281

IMPROVEMENT PERMIT / CERTIFICATE OF COMPLETION / OPERATION PERMIT / EXISTING SYSTEM INSPECTION

PROPERTY DESCRIPTION NO. 16816 DATE 8/23/93 TAX MAP NO. 12K-1-A-19 (PART OF)


ADDRESS 315 S. YATES ST., GASTONIA, NC 28052

LOCATION US 21 N, TR NC 901 E, TL GUILFORD ROAD, ~ 8TH LOT ON (R)

SUBDIVISION EMILY STEWARD VICK Prop. BLOCK / SECTION LOT 19 LOT AREA 9.85 AC SITE CLASS. PS L.T.A.R. 0.30 GPD/FT²

Water Supply: ☒ Individual ☐ Community ☐ Public WELL

Septic Tank: 1000 Gallons: STB 760 Date 7/25/93

Pump Tank: Gallons: PT Date

Nitrification Field: No Fields 1 Square Feet 798 Linear Feet 266

No. Lines 2 Trench Width 36" Trench Depth 18-36" Gravel Depth 12"

☒ New System ☐ Repair System Type: I (II.) III. IV. V. VI

System Description: CONV. GRAVITY

Repair System Description: CONV. GRAVITY

Maintenance Agreement Required: ☐ Yes ☒ No

☐ House/Mod. Home ☐ Mobile Home ☐ Business ☐ Other

No. Bedrooms 2 No. Bathrooms 1 No. Employees

Garbage Disposal: ☐ Yes ☒ No

Auto. Dishwasher: ☒ Yes ☐ No

Auto. Washing Machine: ☒ Yes ☐ No


Other

☐ Slab ☒ Crawl Space ☐ Basement w/plumbing ☐ Basement wo/plumbing

Comments ① KEEP SYSTEM MINIMUM 5' FROM MH, 10' FROM PROPERTY LINE, 100' FROM WELL ② INSTALL LINES ON CONTOUR, NO DEEPER THAN 36", 9' APART ON CENTER

GUILFORD ROAD (SR 2131)

INITIAL SITE SKETCH

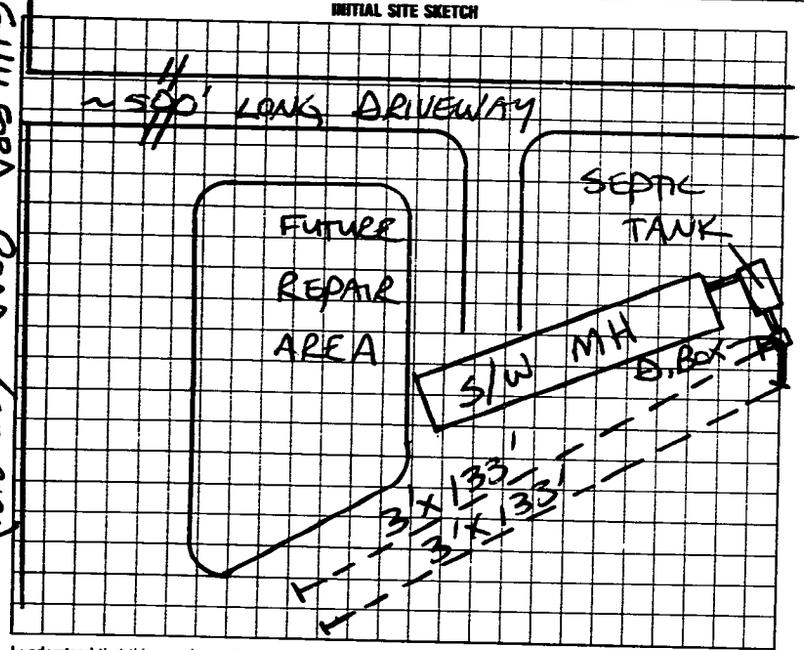

AS BUILT SKETCH

SYSTEM INSTALLED ACCORDING TO INITAL SITE SKETCH

I understand that this permit can be suspended or revoked if any false information is supplied toward securing the permit/any unauthorized changes are made to the site/any unauthorized changes are made in the installation of the system Improvement Permit is valid for 60 months from date of issuance.

Signed: X John Whitcomb

Improvement Permit by: STEVE HEDRICK date 8/23/93

Existing System Inspection by: date

Installed by: LARRY POWELL BACKHOE SERVICE

Certificate of Completion by: STEVE HEDRICK date 8/31/93

Operation Permit by: date

HEALTH DEPT. COPY: WHITE INSPECTION COPY (FINAL): GREEN OWNER COPY (FINAL): YELLOW INSPECTION COPY (INITIAL): PINK OWNER COPY (INITIAL): GOLD