IREDELL COUNTY HEALTH DEPARTMENT

STATESVILLE 704-878-5305 MOORESVILLE 704-664-5281

IMPROVEMENT PERMIT / AUTHORIZATION TO CONSTRUCT / OPERATION PERMIT / EXISTING SYSTEM INSPECTION

PERMIT# 082015 PIN# 4799 16 9573 DATE 7-7-99

OWNER OR CONTRACTOR JEFFREY SHEETS PHONE: Business Home (336) 775-0075

ADDRESS 188 FOXWOOD DRIVE, LEXINGTON NC 27295

LOCATION US 21 N, TR NC 901, TL GUILFORD RD, 1st DRIVE ON RIGHT PAST CALICO SPRINGS DR, 800' BACK ON RIGHT

SUBDIVISION SHEETS PROP BLOCK / SECTION 1 LOT 2 LOT AREA 5.023 Acres SITE CLASS PS DESIGN FLOW 360 L.T.A.R. 0.35 GPD/FT

Septic Tank: 1000 Gallons; STB 1012 Date 8-14-99
Pump Tank: Gallons; PT Date
Pump Make: Model Serial No.
Nitrification Field: No Fields 1 Square Feet 1035 Linear Feet 345
No Lines THREE Trench Width 36" Max Trench Bottom Depth 36" Gravel Depth 12"

☑ New System ☐ Repair System Type: I II III IV V VI
System Description: CONVENTIONAL GRAVITY
Repair System Description: CONV. GRAVITY
Maintenance Agreement Required: Yes ☑ No
☐ Slab ☑ Crawl Space ☐ Basement w/plumbing ☐ Basement wo/plumbing

☐ House/Mod. Home No. Bedrooms 3
☑ Mobile Home No. Bathrooms 2
☐ Business No. Employees
☐ Other


Water Supply: ☑ Individual ☐ Public ☐ Community WELL

Comments/Conditions: KEEP SYSTEM MINIMUM 100 FEET FROM WELL


Comments/Conditions: ① SYSTEM ALTERED AS SHOWN BELOW WITH PRIOR APPROVAL FROM HEALTH DEPT. ② SEPTIC TANK WITH MARKER INSTALLED USING "POLYLOK" FILTER

SCALE: 1" = 40'

INITIAL SITE SKETCH

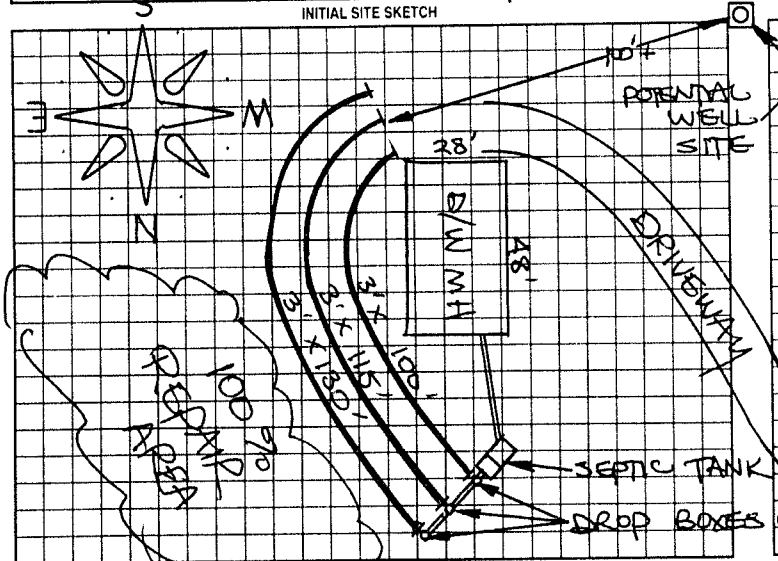

AS BUILT SKETCH

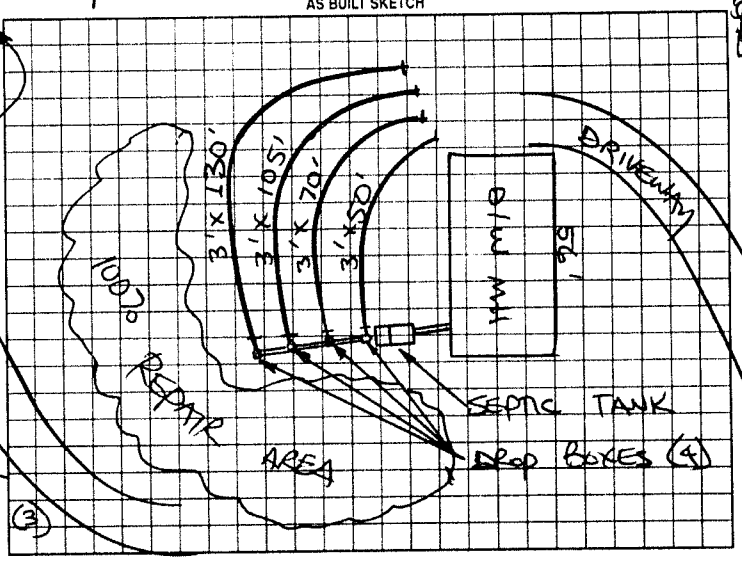

Permit can be suspended or revoked if any false information is supplied toward securing the permit/any unauthorized changes are made to the site/any unauthorized changes are made in the installation of the system. Improvement Permit with plat valid without expiration. Improvement Permit with site plan valid for sixty months. Authorization to Construct is valid for a period equal to that of Improvement Permit - not to exceed sixty months.

Signed: Jeffrey W. Sheets date 2-7-99

Improvement Permit by: STEVE HEDRICK date 7-7-99

Authorization to Construct by: STEVE HEDRICK date 7-7-99

Installed by: A-1 BACKHOE

Operation Permit by: STEVE HEDRICK date 10-28-99

Existing System Inspection by: date

HEALTH DEPT COPY WHITE OWNER COPY (FINAL) YELLOW OWNER COPY (INITIAL) PINK