IREDELL COUNTY HEALTH DEPARTMENT

STATESVILLE 704-878-5305 MOORESVILLE 704-664-5281

IMPROVEMENT PERMIT / AUTHORIZATION TO CONSTRUCT / OPERATION PERMIT / EXISTING SYSTEM INSPECTION

PERMIT# 082016 PIN# 4799 16 9573 DATE 7-7-99

OWNER OR CONTRACTOR KEITH ALAN SHEETS PHONE: Business _____ Home (336) 764-9575

ADDRESS P.O. BOX 2016, WELCOME, NC 27374

LOCATION US 21 N, TR NC 901, TL GUILFORD, 1ST DRIVE ON RIGHT PAST CALICO SPRINGS DR, ~450' BACK

SUBDIVISION SHEETS PROP. BLOCK / SECTION _____ LOT 1 LOT AREA 3.918 ACRES SITE CLASS PS DESIGN FLOW 360 L.T.A.R. 0.33 gpd/ft²

Septic Tank: 1000 Gallons; STB 1012 Date 8-14-99
Pump Tank: _____ Gallons; PT _____ Date _____
Pump Make: _____ Model _____ Serial No. _____
Nitrification Field: No Fields 1 Square Feet 1080 Linear Feet 360
No Lines FOUR Trench Width 36" Max Trench Bottom Depth 36" Gravel Depth 12"


☑ New System ☐ Repair System Type: I II III IV V VI
System Description: CONVENTIONAL, GRAVITY
Repair System Description: CONV. GRAVITY
Maintenance Agreement Required: ☐ Yes ☑ No

☐ House/Mod. Home ☑ Mobile Home ☐ Business ☐ Other
No. Bedrooms 3 No. Bathrooms 2 No. Employees _____
☐ Slab ☐ Crawl Space ☐ Basement w/plumbing ☐ Basement wo/plumbing

Water Supply: ☑ Individual ☐ Public ☐ Community WELL


Comments/Conditions: KEEP SYSTEM MINIMUM 100 FEET FROM WELL

SCALE: 1"=40' INITIAL SITE SKETCH

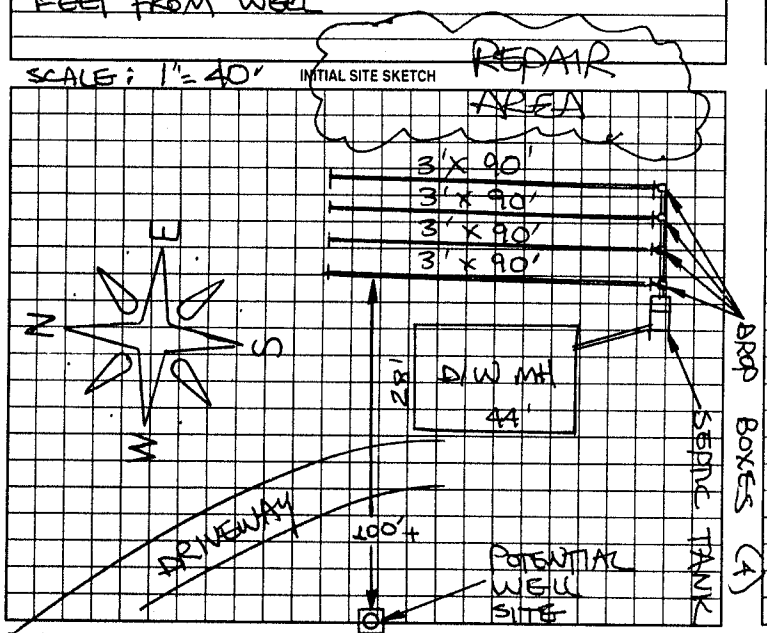

Comments/Conditions: ① SYSTEM ALTERED AS SHOWN WITH PRIOR APPROVAL FROM HEALTH DEPARTMENT. ② SEPTIC TANK WITH MARKER INSTALLED USING "POLYLOK" FILTER

AS BUILT SKETCH

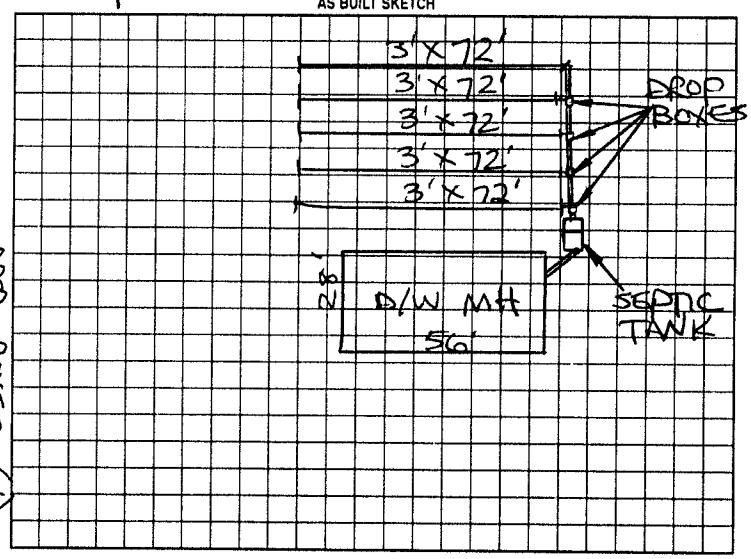

Permit can be suspended or revoked if any false information is supplied toward securing the permit/any unauthorized changes are made to the site/any unauthorized changes are made in the installation of the system. Improvement Permit with plat valid without expiration. Improvement Permit with site plan valid for sixty months. Authorization to Construct is valid for a period equal to that of Improvement Permit – not to exceed sixty months.

Signed: Keith Alan Sheets date 7-7-99

Improvement Permit by: STEVE HEDRICK date 7-7-99

Authorization to Construct by: STEVE HEDRICK date 7-7-99

Installed by: A-1 BACKHOE

Operation Permit by: STEVE HEDRICK date 10-25-99

Existing System Inspection by: _____ date _____

HEALTH DEPT COPY: WHITE OWNER COPY (FINAL): YELLOW OWNER COPY (INITIAL): PINK