IREDELL COUNTY HEALTH DEPARTMENT

STATESVILLE 704-878-5305 MOORESVILLE 704-664-5281

IMPROVEMENT PERMIT / CERTIFICATE OF COMPLETION / OPERATION PERMIT / EXISTING SYSTEM INSPECTION

PROPERTY DESCRIPTION NO. 069042 DATE 9-11-97 TAX MAP NO. 4799 30 7690 Watershed: ☐ Yes ☒ No

OWNER OR CONTRACTOR ROBERT E. CARTNER PHONE: Business 492-7960 Home 546-7563

ADDRESS 1405 E. MEMORIAL HIGHWAY, HARMONY NC 28634

LOCATION US 21 N, TR NC 901, ON LEFT JUST BEFORE COUNTY LINE AT BOX # 1405

SUBDIVISION _____ BLOCK / SECTION _____ LOT _____ LOT AREA AMPLE SITE CLASS. P3 DESIGN FLOW 480 L.T.A.R. 0.40 GPD/FT²

Septic Tank: 1000 Gallons; STB 760 Date 8-16-97
Pump Tank: _____ Gallons; PT _____ Date _____
Pump Make: _____ Model _____ Serial No. _____
Nitrification Field: No Fields 1 Square Feet 1200 Linear Feet 400
No Lines FOUR Trench Width 36" Max Trench Bottom Depth 36" Gravel Depth 12"

☒ New System ☐ Repair System Type: I, II, III, IV, V, VI
System Description: CONVENTIONAL GRAVITY
Repair System Description: CONV. GRAVITY
Maintenance Agreement Required: ☐ Yes ☒ No

☐ House/Mod. Home ☒ Mobile Home ☐ Business ☐ Other
No. Bedrooms 4 No. Bathrooms 2 No. Employees ____


☐ Slab ☒ Crawl Space ☐ Basement w/plumbing ☐ Basement wo/plumbing

Water Supply: ☐ Individual ☐ Community ☒ Public

Comments: SEE ATTACHED EASEMENT

Comments:

INITIAL SITE SKETCH

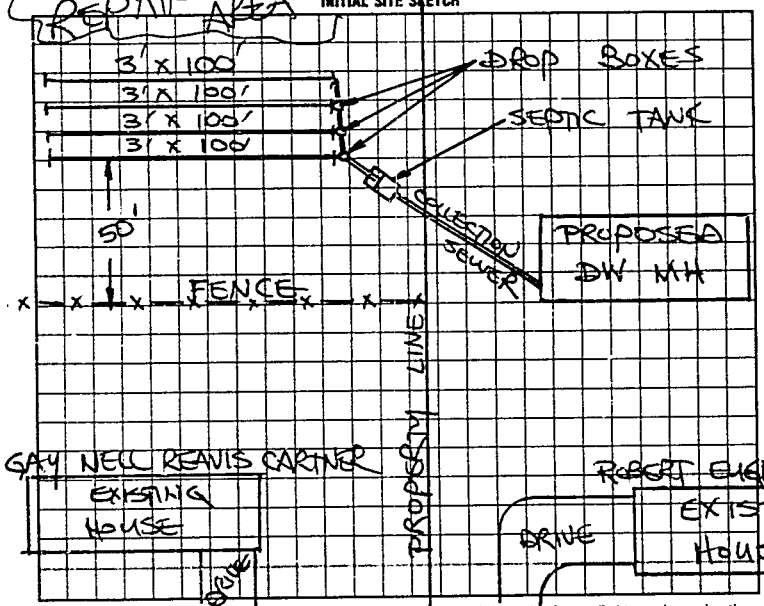

AS BUILT SKETCH

SYSTEM INSTALLED ACCORDING TO INITIAL SITE SKETCH.

I understand that this permit can be suspended or revoked if any false information is supplied toward securing the permit/any unauthorized changes are made to the site/any unauthorized changes are made in the installation of the system. Improvement Permit is valid for 60 months from date of issuance. AUTHORIZATION TO CONSTRUCT IS VALID FOR 60 MONTHS FROM DATE OF ISSUANCE.

Signed: Robert E. Cartner

Installed by: DONALD LAKEY

Improvement Permit by: STEVE HEDRICK date 9-11-97

AUTH. TO CONST. ~~Existing System Inspection~~ by: STEVE HEDRICK date 9-11-97

~~Certificate of Completion by:~~ _____ date _____

Operation Permit by: STEVE HEDRICK date 10-16-97

HEALTH DEPT. COPY: WHITE INSPECTION COPY (FINAL): GREEN OWNER COPY (FINAL): YELLOW INSPECTION COPY (INITIAL): PINK OWNER COPY (INITIAL): GOLD

6200000