Not on Book — Information given to Mr Johnson.

IREDELL COUNTY HEALTH DEPARTMENT

Statesville Phone TR 3-7271 Mooresville Phone NO 3-1271

PERMIT TO INSTALL SEPTIC TANK

Permit No. _____ Permit Date July 8 1970

Owner Perry CARTNER Address Route 1, Harmony

Installed By GRAY A. LAYMON Address Route 5, Mocksville


Location of Property Highway 901 West, about ½ mile inside county on left

Tank		Capacity		Length of Lines		Fixtures	
Block	( )	1000	(✓)	225'	(✓)	No. of Baths	(2)
Precast	(✓)	1250	( )	250'	( )	Dishwasher	( )
		1500	( )	Other _____		Garbage Grdr.	( )
		Other _____				Other _____	

NOTIFY HEALTH DEPARTMENT AT LEAST EIGHT HOURS BEFORE TANK IS TO BE INSPECTED.

Final Inspection July 8 1970 Approved (✓) Disapproved ( )

Remarks _____

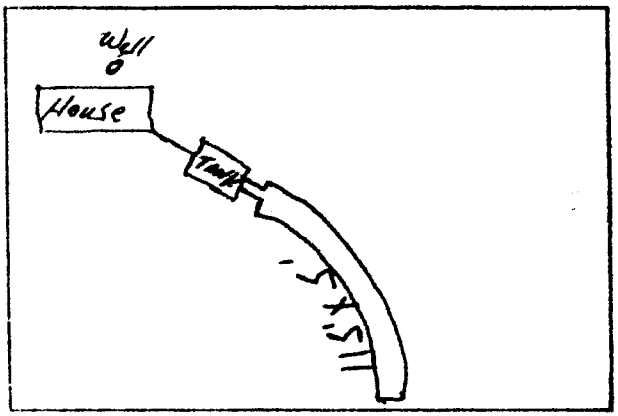

Sketch of Installation

R. W. Johnson

Sanitarian