IREDELL COUNTY HEALTH DEPARTMENT

STATESVILLE 704-878-5305 MOORESVILLE 704-664-5281

IMPROVEMENT PERMIT / CERTIFICATE OF COMPLETION / OPERATION PERMIT / EXISTING SYSTEM INSPECTION

PROPERTY DESCRIPTION NO. 19943 DATE 12/28/94 TAX MAP NO. 12K-A-78 Watershed: ☐ Yes ☑ No

OWNER OR CONTRACTOR ROY A. GAITHER, JR PHONE: Business Home 546-7825

ADDRESS 1106 E. MEMORIAL HWY, HARMONY, NC 28634

LOCATION US 21 N, TR NC 901, TL GUILFORD ROAD ~0.9 MILE ON LEFT

SUBDIVISION BLOCK / SECTION LOT 1 LOT AREA 10 ACRES SITE CLASS. PS DESIGN FLOW 360 L.T.A.R. 0.35 gpd/ft²

Septic Tank: 1000 Gallons; STB 620 Date 10/4/94

Pump Tank: Gallons; PT Date

Pump Make: Model Serial No.

Nitrification Field: No Fields 1 Square Feet 1035 Linear Feet 345

No Lines 3 Trench Width 36 Max Trench Bottom Depth 18-36" Gravel Depth 12"

☑ New System ☐ Repair System Type: I, II, III, IV, V, VI

System Description: CONVENTIONAL GRAVITY

Repair System Description: CONV. GRAVITY

Maintenance Agreement Required: ☐ Yes ☑ No

☐ Slab ☑ Crawl Space ☐ Basement w/plumbing ☐ Basement wo/plumbing

☐ House/Mod. Home No. Bedrooms 3

☑ Mobile Home No. Bathrooms 2

☐ Business No. Employees


☐ Other

Water Supply: ☑ Individual ☐ Community ☐ Public

Comments: ① KEEP SYSTEM MINIMUM 5' FROM MH, 10' FROM PROPERTY LINE, 100' FROM WELL (2) INSTALL LINES ON CONTOUR, NO DEEPER THAN 36", 9' APART ON CENTER

Comments:

INITIAL SITE SKETCH

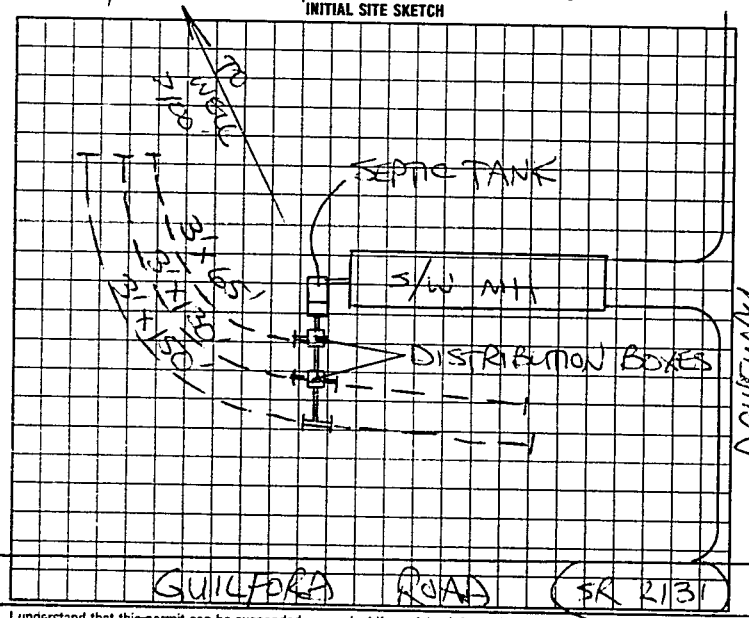

AS BUILT SKETCH

SYSTEM INSTALLED ACCORDING TO INITIAL SITE SKETCH

I understand that this permit can be suspended or revoked if any false information is supplied toward securing the permit/any unauthorized changes are made to the site/any unauthorized changes are made in the installation of the system. Improvement Permit is valid for 60 months from date of issuance.

Signed: [signature]

Improvement Permit by: STEVE HENDRICK date 12/28/94

Existing System Inspection by: date

Installed by: SAMMY REAVIS

Certificate of Completion by: STEVE HENDRICK date 1/5/95

Operation Permit by: date

HEALTH DEPT. COPY: WHITE INSPECTION COPY (FINAL): GREEN OWNER COPY (FINAL): YELLOW INSPECTION COPY (INITIAL): PINK OWNER COPY (INITIAL): GOLD