IREDELL COUNTY HEALTH DEPARTMENT

STATESVILLE 704-878-5305 MOORESVILLE 704-664-5281

IMPROVEMENT PERMIT / CERTIFICATE OF COMPLETION / OPERATION PERMIT / EXISTING SYSTEM INSPECTION

PROPERTY DESCRIPTION NO. 17129 DATE 10/1/93 TAX MAP NO. 12K-A-2B

OWNER OR CONTRACTOR ZACHARIEH GAITHER PHONE: Business Home 546-7825

ADDRESS RT. 1, BOX 300, HARMONY NC 28634

LOCATION US 21 N, TR NC 901 E, TL GUILFORD ROAD, ~ 0.9 MILE ON (L) AT POULTRY HOUSE

SUBDIVISION BLOCK / SECTION LOT LOT AREA SITE CLASS PS L.T.A.R EXISTING

Water Supply: (✓) Individual ( ) Community ( ) Public

Septic Tank: EXISTING Gallons: STB Date

Pump Tank: Gallons: PT Date

Nitrification Field: No Fields 1 Square Feet Linear Feet EXISTING

No Lines 2 Trench Width Trench Depth Gravel Depth

( ) New System ( ) Repair System Type: (I) II III IV V VI

System Description: CONV. GRAVITY

Repair System Description:

Maintenance Agreement Required: ( ) Yes (✓) No

House/Mod. Home No. Bedrooms 3

(✓) Mobile Home No. Bathrooms 2

Business No. Employees

Other

Slab (✓) Crawl Space Basement w/plumbing Basement wo/plumbing

Garbage Disposal: ( ) Yes (✓) No

Auto. Dishwasher: ( ) Yes (✓) No


Auto. Washing Machine: (✓) Yes ( ) No

Other

Comments: KEEP MH MINIMUM 5' FROM SEPTIC SYSTEM

INITIAL SITE SKETCH

AS BUILT SKETCH

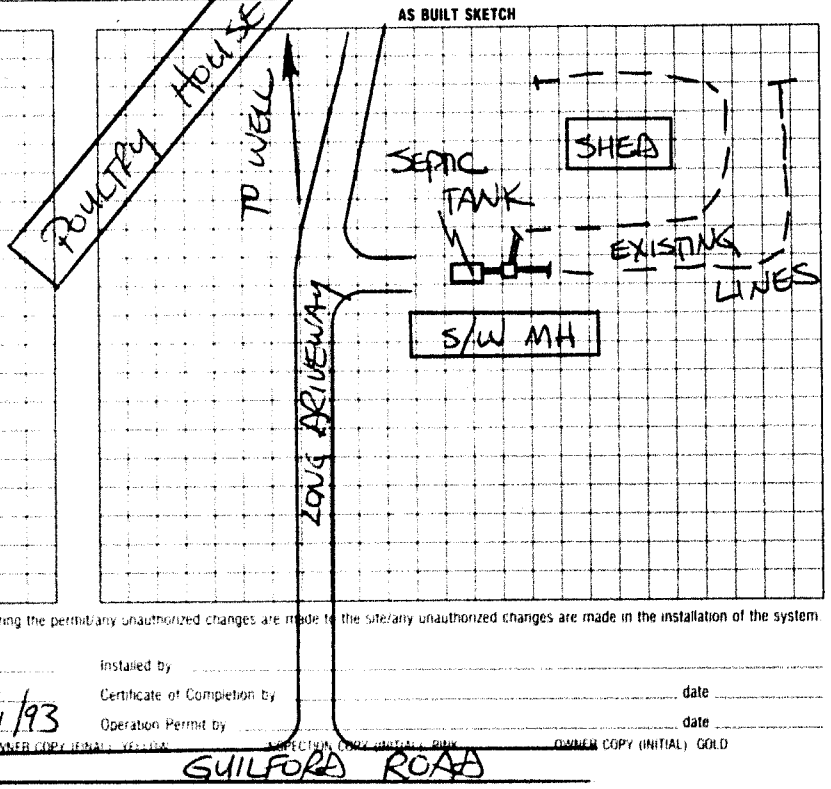

I understand that this permit can be suspended or revoked if any false information is supplied toward securing the permit/any unauthorized changes are made to the site/any unauthorized changes are made in the installation of the system. Improvement Permit is valid for 60 months from date of issuance

Signed:

Improvement Permit by date

Existing System Inspection by STEVE HEDRICK date 10/1/93

Installed by

Certificate of Completion by date

Operation Permit by date

HEALTH DEPT COPY WHITE INSPECTION COPY (FINAL) GREEN OWNER COPY (FINAL) YELLOW INSPECTION COPY (INITIAL) PINK OWNER COPY (INITIAL) GOLD