IREDELL COUNTY HEALTH DEPARTMENT

Statesville Office (704) 878-5305 Mooresville Office (704) 660-3625 PERMIT # 204208

IMPROVEMENT PERMIT / AUTHORIZATION TO CONSTRUCT / OPERATION PERMIT / EXISTING SYSTEM

PIN # 4794472474

APPLICANT: Frances Rupard APPLICANT ADDRESS: 5421 Wilkesboro Hwy

SITE ADDRESS: 321 Guilford Rd Harmony NC 28634 PHONE: 704-239-3643 ALT. PHONE: N/A

SITE DIRECTIONS: 40E take Exit 162 (L) on 64E (L) on 901N (R) on Guilford Rd Property on left

SUBDIVISION: N/A SECTION: N/A LOT # N/A LOT AREA: 12.06ac DESIGN FLOW: 240 L.T.A.R.: 0.25

Septic Tank	1000 (gal)	STB	760	Date	3-23-14	[X] New System [ ] Repair [ ] Expansion	System Type: I II [III] IV V VI
Pump Tank	N/A (gal)	PT	N/A	Date	N/A	System Description:	25% Reduction
Pump Make	N/A	Model	Poly Tech	Serial #	P1-64	Repair System Description:	25% Reduction
# Nitrification Fields	1	# Lines	2	Linear Ft:	240	Maintenance Agreement Required:	[ ] YES [X] NO
Trench Width	36"	Max. Trench Bottom Depth	36"	Gravel Depth	N/A	[X] GRAVITY	[ ] PRESSURE


[X] Residence No. Bedrooms 2
[ ] Business No. Persons 4
[ ] Other No. Employees
[ ] Slab [X] Crawl Space
[ ] Basement w/plumbing

Water Supply: [X] Private [ ] Public [ ] Community


[ ] Basement w/o plumbing

Comments / Conditions: Install 25% reduction on center with serial distribution.

INITIAL SITE SKETCH

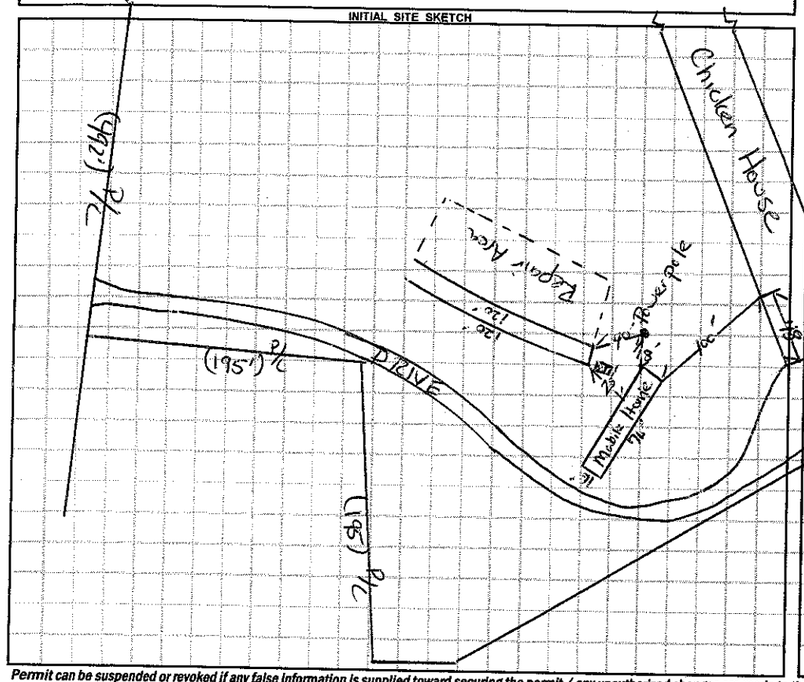

AS BUILT SKETCH

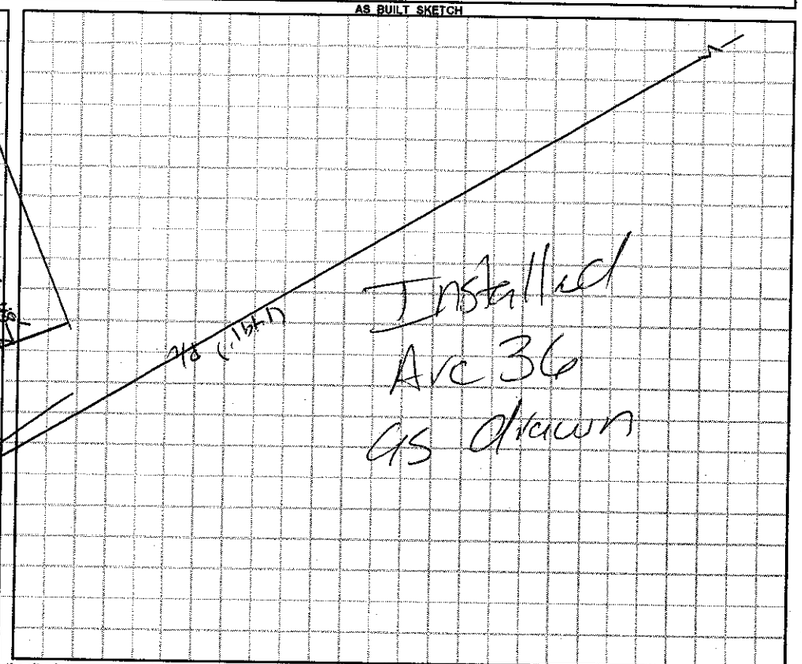

Permit can be suspended or revoked if any false information is supplied toward securing the permit / any unauthorized changes are made to the site / any unauthorized changes are made in the installation of the system. **CONTACT A LOCATOR SERVICE PRIOR TO ANY EXCAVATION**

[ ] **IMPROVEMENT PERMIT** *with plat valid without expiration.* [X] **IMPROVEMENT PERMIT** *with site plan valid for 60 mos.* [X] **AUTHORIZATION TO CONSTRUCT** *valid for period equal to IMPROVEMENT PERMIT--not to exceed 60 mo.*

Owner / Applicant Signature: Deena Abee Date: 7/24/14 Installed by: Tim Abee

IMPROVEMENT PERMIT by: Date: 07/23/14 OPERATION PERMIT by: Date: 08/01/14

AUTHORIZATION TO CONSTRUCT by: Date: 07/24/14 Existing System Inspected by: Date:

Health Dept. Copy - WHITE Applicant (Final Approval) - YELLOW Applicant (Conditional Approval) - PINK