IREDELL COUNTY HEALTH DEPARTMENT

Statesville Office (704) 878-5305 Mooresville Office (704) 660-3625 PERMIT # 207382

IMPROVEMENT PERMIT / AUTHORIZATION TO CONSTRUCT / OPERATION PERMIT / EXISTING SYSTEM

PIN # 4799579023

APPLICANT: Clay Gentry APPLICANT ADDRESS: 156 Kingswood Drive

SITE ADDRESS: 391 Guilford Rd. PHONE: 704-902-1537 ALT. PHONE: N/A

SITE DIRECTIONS: Hwy 21 N TR Hwy 901 TL Guilford Rd. Property on Left Just before Davie Co.


SUBDIVISION: N/A SECTION: N/A LOT # N/A LOT AREA: 8.88 acres DESIGN FLOW: 360gpd L.T.A.R.: 0.275

Septic Tank	1000 (gal)	STB	1612-1000	Date	3-11-15	☑ New System ☐ Repair ☐ Expansion	System Type: I II III IV V VI	☑ Residence	No. Bedrooms 3
Pump Tank	(gal)	PT		Date		System Description:	25% Reduction	☐ Business	No. Persons 6
Pump Make		Model		Serial #		Repair System Description:	25% Reduction	☐ Other	No. Employees
# Nitrification Fields	1	# Lines	4	Linear Ft:	328'	Maintenance Agreement Required:	☐ YES ☑ NO	☐ Slab	☑ Crawl Space
Trench Width	36"	Max. Trench Bottom Depth	36"	Gravel Depth	N/A	☑ GRAVITY ☐ PRESSURE		☐ Basement w/plumbing	☐ Basement w/o plumbing


Water Supply: ☑ Private ☐ Public ☐ Community

Comments / Conditions: Install a 25% Reduction System on contour with serial distribution.

INITIAL SITE SKETCH

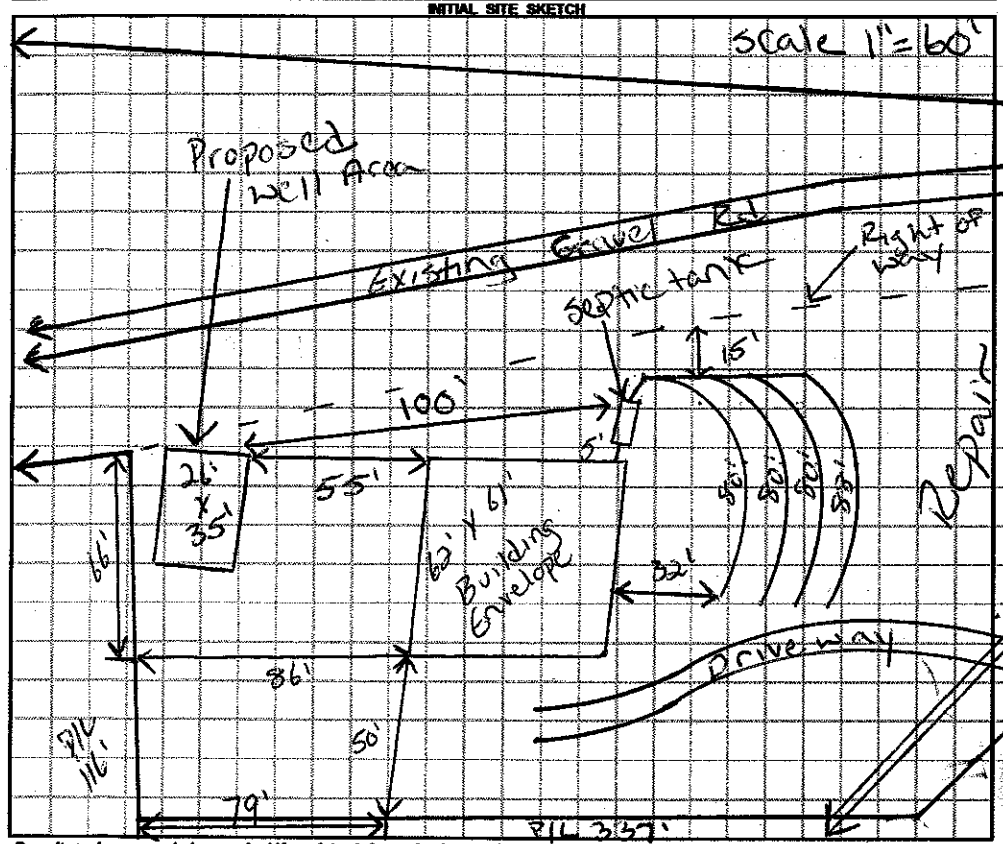

AS BUILT SKETCH

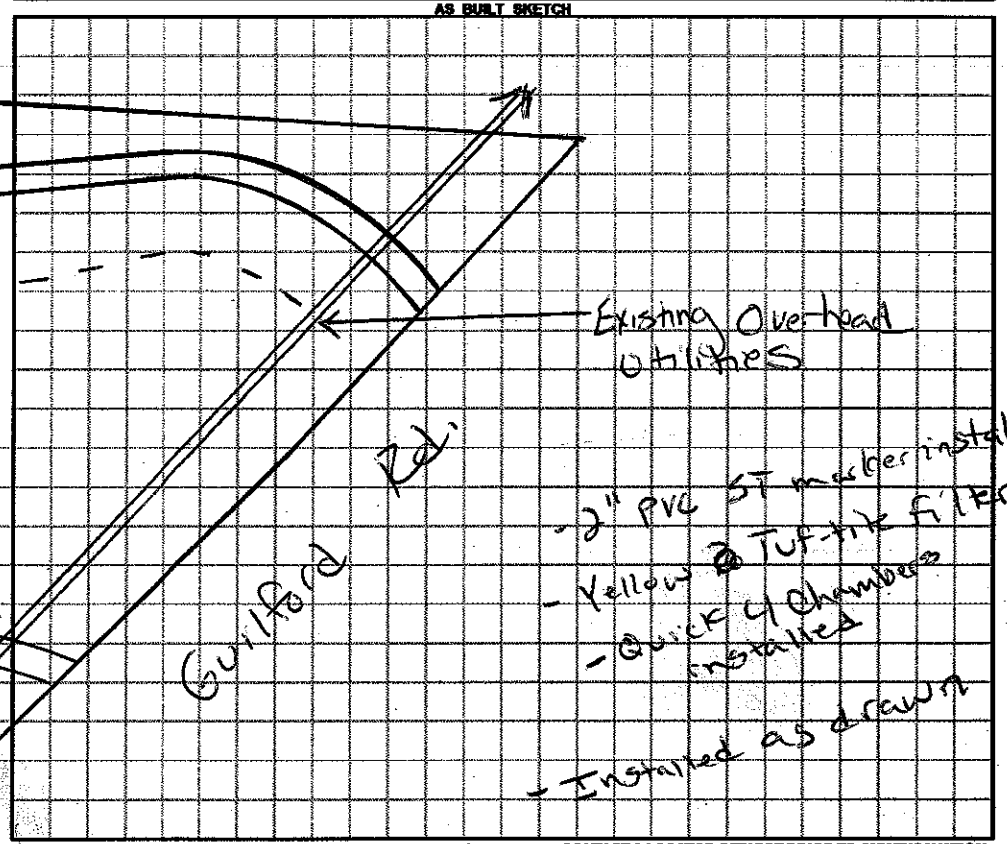

Permit can be suspended or revoked if any false information is supplied toward securing the permit / any unauthorized changes are made to the site / any unauthorized changes are made in the installation of the system. **CONTACT A LOCATOR SERVICE PRIOR TO ANY EXCAVATION**

☐ **IMPROVEMENT PERMIT** *with plat valid without expiration.* ☑ **IMPROVEMENT PERMIT** *with site plan valid for 60 mos.* ☑ **AUTHORIZATION TO CONSTRUCT** *valid for period equal to IMPROVEMENT PERMIT—not to exceed 60 mo.*

Owner / Applicant Signature: Clay Gentry Date: 2-13-15 Installed by: Tommy Frye

IMPROVEMENT PERMIT by: Justin Henderson Date: 2-12-15 OPERATION PERMIT by: Justin Henderson Date:

AUTHORIZATION TO CONSTRUCT by: Justin Henderson Date: 2-13-15 Existing System Inspected by: Date:

Health Dept. Copy - WHITE Applicant (Final Approval) - YELLOW Applicant (Conditional Approval) - PINK