IREDELL COUNTY HEALTH DEPARTMENT

STATESVILLE 704-878-5305 MOORESVILLE 704-664-5281

IMPROVEMENT PERMIT / AUTHORIZATION TO CONSTRUCT / OPERATION PERMIT / EXISTING SYSTEM INSPECTION

PERMIT# 9573 PIN# 4799 57 8987 DATE 3-9-99

OWNER OR CONTRACTOR COLLEEN CAVE PHONE: Business Home 546-2790

ADDRESS 399 GUILFORD ROAD, HARMONY, NC 28634

LOCATION US 21 North, TR NC 901, TL GUILFORD ROAD, ON LEFT PAST DAVIE COUNTY LINE OFF ROAD

SUBDIVISION BLOCK / SECTION LOT LOT AREA 5.66 ACRES SITE CLASS PS DESIGN FLOW 240 L.T.A.R. 0.33 GPD/FT2

Septic Tank: 1000 Gallons; STB 1012 Date 2-22-99
Pump Tank: Gallons; PT Date
Pump Make: Model Serial No.
Nitrification Field: No Fields 1 Square Feet 720 Linear Feet 240
No Lines THREE Trench Width 36" Max Trench Bottom Depth 36" Gravel Depth 12"

☑ New System ☐ Repair System Type: I (II) III IV V VI
System Description: CONVENTIONAL GRAVITY
Repair System Description: CONV. GRAVITY
Maintenance Agreement Required. ☐ Yes ☑ No

☐ House/Mod. Home No. Bedrooms 2
☑ Mobile Home No. Bathrooms 2
☐ Business No. Employees
☐ Other
☑ Slab ☑ Crawl Space Basement w/plumbing ☐ Basement wo/plumbing


Water Supply: ~~Individual~~ ☐ Public ☐ Community WELL

Comments/Conditions:


Comments /Conditions

SCALE: 1" = 50'

INITIAL SITE SKETCH

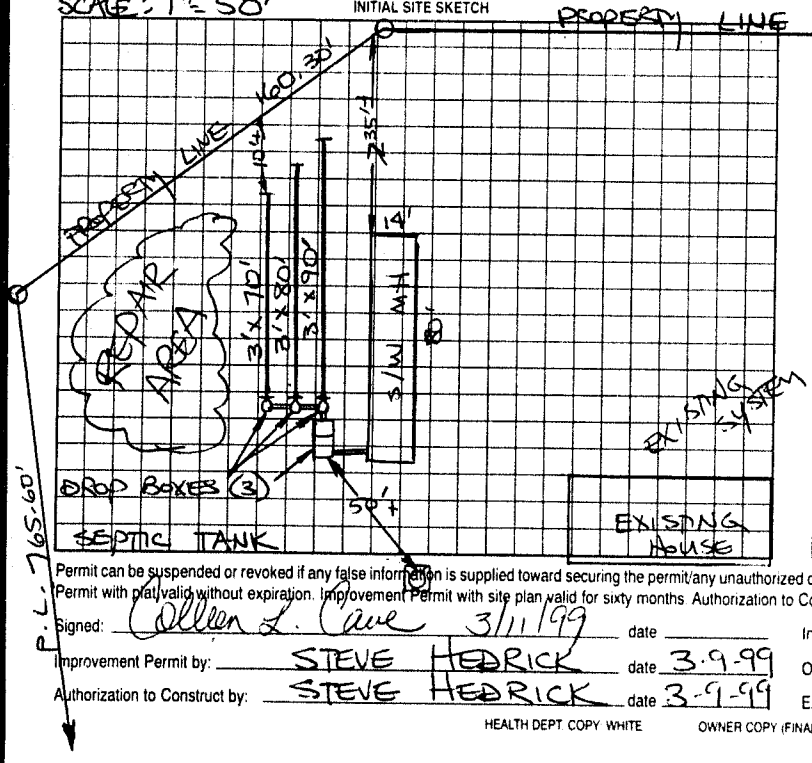

AS BUILT SKETCH

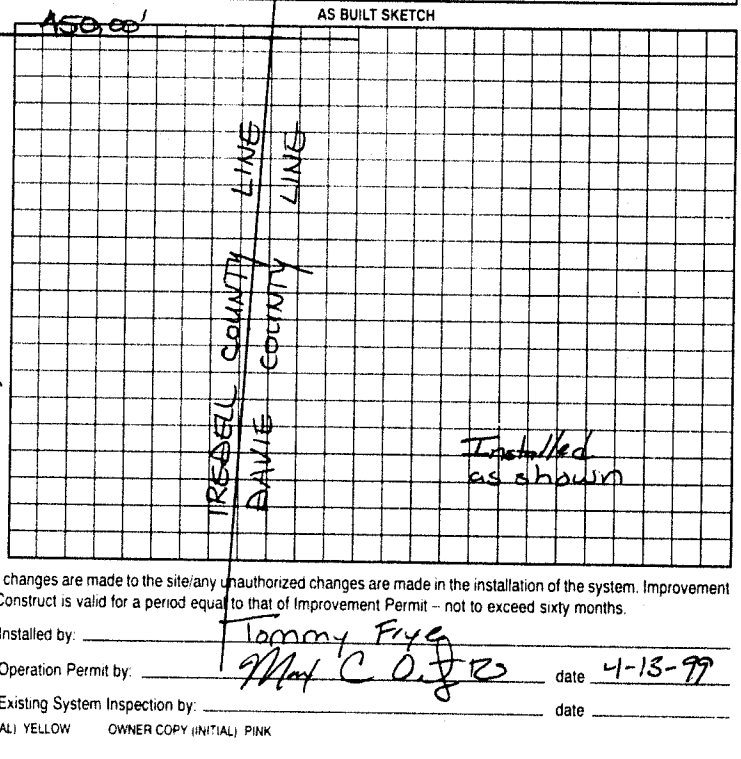

Permit can be suspended or revoked if any false information is supplied toward securing the permit/any unauthorized changes are made to the site/any unauthorized changes are made in the installation of the system. Improvement Permit with plat valid without expiration. Improvement Permit with site plan valid for sixty months. Authorization to Construct is valid for a period equal to that of Improvement Permit – not to exceed sixty months.

Signed: Colleen L. Cave 3/11/99 date

Improvement Permit by: STEVE HEDRICK date 3-9-99

Authorization to Construct by: STEVE HEDRICK date 3-9-99

Installed by: Tommy Frye

Operation Permit by: Mark C. Ford date 4-13-99

Existing System Inspection by: date

HEALTH DEPT COPY WHITE OWNER COPY (FINAL) YELLOW OWNER COPY (INITIAL) PINK