IREDELL COUNTY HEALTH DEPARTMENT

THIS PERMIT VOIDS #090718 ISSUED 8-7-2000

STATESVILLE 704-878-5305 MOORESVILLE 704-664-5281

IMPROVEMENT PERMIT / AUTHORIZATION TO CONSTRUCT / OPERATION PERMIT / EXISTING SYSTEM INSPECTION

PERMIT# 093900 PIN# (336) 284 6641 DATE 1-27-2001

OWNER OR CONTRACTOR RONALD PARSONS PHONE: Business Home (336) 284-6641

ADDRESS 118 YANKEE LANE, MOCKSVILLE, NC 27028

LOCATION US 21N, TR NC 901 TL GUILFORD RD, TL FOX HUNTER, TR PINEY GROVE, DRIVE ON (R) AT COUNTY LINE 1100' BACK

SUBDIVISION BLOCK / SECTION LOT LOT AREA 12.43 ACRES SITE CLASS PS DESIGN FLOW 480 L.T.A.R. 0.80 APPT

Septic Tank: 1000 Gallons; STB 620 Date 10-22-00

Pump Tank: Gallons; PT Date

Pump Make: Model Serial No.

Nitrification Field: No. Fields 1 Square Feet 1600 Linear Feet 533

No. Lines FOUR Trench Width 36" Max. Trench Bottom Depth 36" Gravel Depth 12"

(X) New System ( ) Repair System Type: I (II) III IV V VI

System Description: CONVENTIONAL GRAVITY

Repair System Description: CONV. GRAVITY

Maintenance Agreement Required: ( ) Yes (X) No

( ) House/Mod. Home No. Bedrooms 4

( ) Mobile Home No. Bathrooms 2

( ) Business No. Employees

( ) Other

( ) Slab ( ) Crawl Space ( ) Basement w/plumbing ( ) Basement wo/plumbing

Water Supply: (X) Individual ( ) Public ( ) Community WELL


Comments/Conditions: KEEP SYSTEM MINIMUM 100 FEET FROM WELL

Comments/Conditions


= Tuff-Tite Filter Installed

= Septic Tank Risers Installed

INITIAL SITE SKETCH

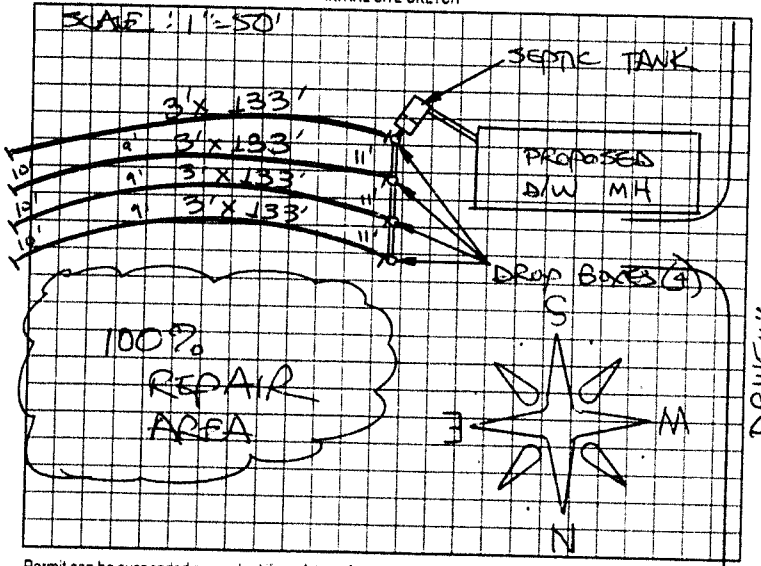

AS BUILT SKETCH

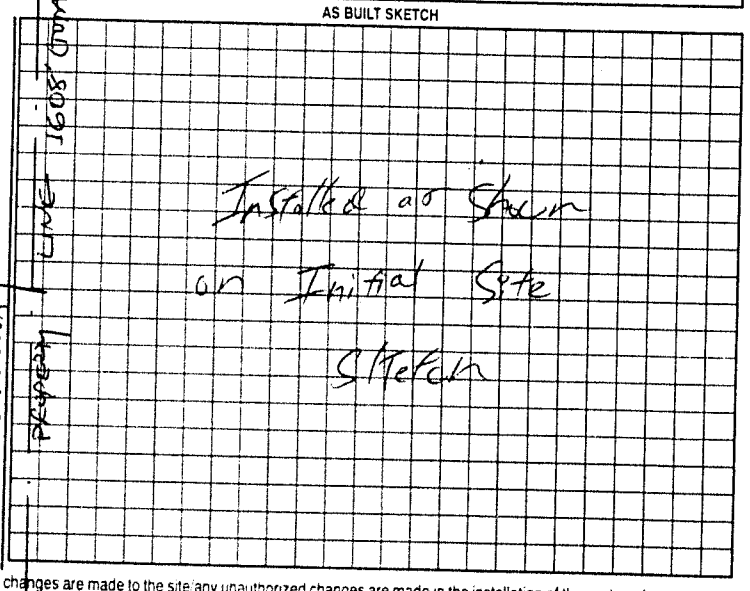

Permit can be suspended or revoked if any false information is supplied toward securing the permit; any unauthorized changes are made to the site; any unauthorized changes are made in the installation of the system. Improvement Permit with plat valid without expiration. Improvement Permit with site plan valid for sixty months. Authorization to Construct is valid for a period equal to that of Improvement Permit – not to exceed sixty months.

Signed: X for Parsons date 1-27-01

Improvement Permit by: STEVE HEDRICK date 1-27-01

Authorization to Construct by: STEVE HEDRICK date 1-27-01

Installed by: Sammy Lewis

Operation Permit by: William O. Johnson date 4/16/01

Existing System Inspection by: date

HEALTH DEPT. COPY WHITE OWNER COPY (FINAL) YELLOW OWNER COPY (INITIAL) PINK