IREDELL COUNTY HEALTH DEPARTMENT

STATESVILLE 704-878-5305 MOORESVILLE 704-664-5281

IMPROVEMENT PERMIT / AUTHORIZATION TO CONSTRUCT / OPERATION PERMIT / EXISTING SYSTEM INSPECTION

PERMIT# 14239 PIN# 4799591220 DATE 5 June 07

OWNER OR APPLICANT Ronald Harrington PHONE: Business Home 704-425-2258

ADDRESS 324 Pine Grove RD Harmony NC 28634

LOCATION 21N (TR) 901 (TR) Cullaton (TR) Fox Hunter (TR) Pine Grove RD 3/4 on Rt

SUBDIVISION BLOCK / SECTION LOT LOT AREA 30 A SITE CLASS IS DESIGN FLOW 480 L.T.A.R. .3

Septic Tank: 1000 Gallons; STB 500 Date 7-1-07

Pump Tank: Gallons; PT Date

Pump Make: Model Serial No.

Nitrification Field: No Fields Square Feet 1400 Linear Feet 400

No Lines 4 Trench Width 36" Max Trench Bottom Depth 24" Gravel Depth 24" ☐ Gravity ☐ Pressure

☐ New System ☐ Repair ☐ Expansion System Type: I II III IV V VI

System Description: 25% Reduction Gravity

Repair System Description: 25% Reduction Gravity

Maintenance Agreement Required: ☐ Yes ☐ No

☐ House/Mod. Home ☐ Mobile Home ☐ Business ☐ Other

No. Bedrooms 3 No. Persons No. Employees

Water Supply: ☐ Individual ☐ Public ☐ Community

☐ Slab ☐ Crawl Space ☐ Basement w/plumbing ☐ Basement wo/plumbing


Comments:/Conditions:

Maintain 100' away from Septic with all of it

Comments:/Conditions:


#24" Trench Bottom

INITIAL SITE SKETCH (NOT TO SCALE)

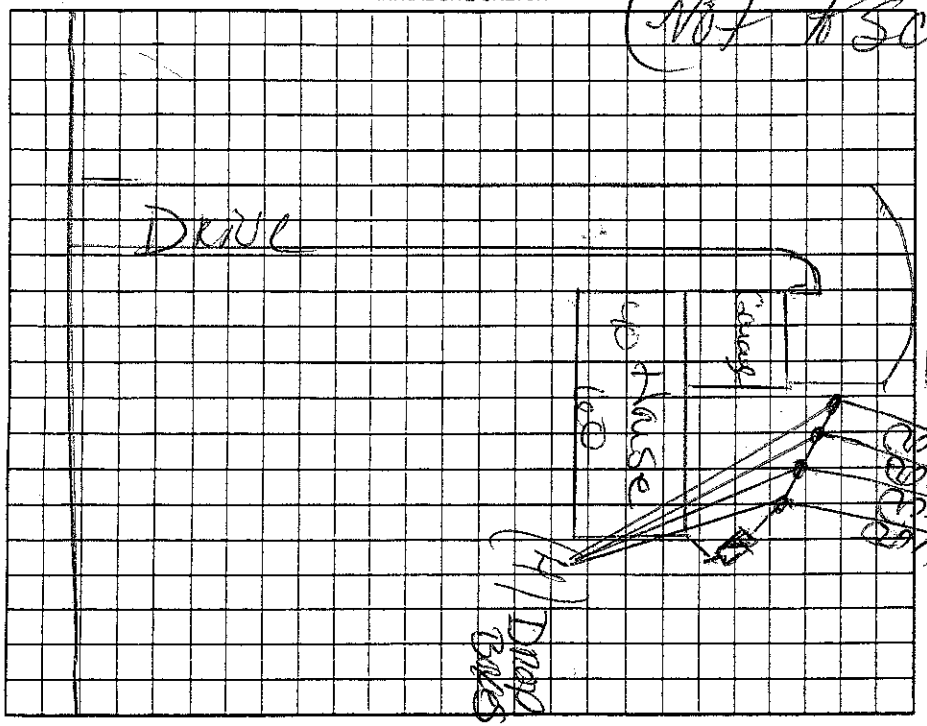

AS BUILT SKETCH

Range Balcon Gutter

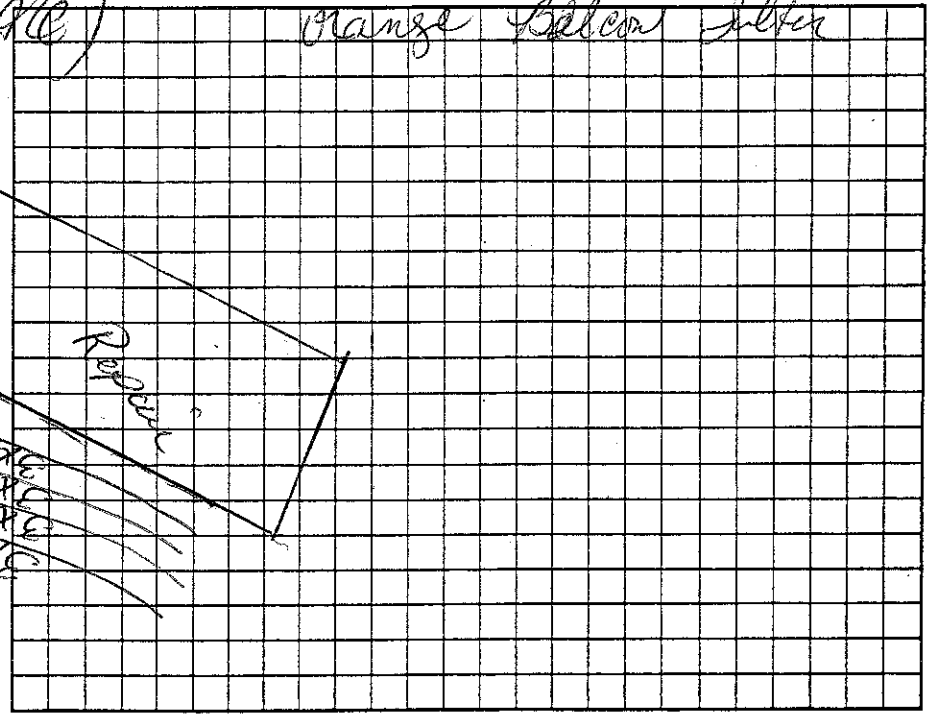

Permit can be suspended or revoked if any false information is supplied toward securing the permit/any unauthorized changes are made to the site/any unauthorized changes are made in the installation of the system. Improvement Permit with plat valid without expiration ☐ Improvement Permit with site plan valid for sixty months ☐ Authorization to Construct is valid for a period equal to that of Improvement Permit – not to exceed sixty months.

Signed: date 6-5-07 Installed by: K&S Grading

Improvement Permit by: date 5 June 07 Operation Permit by: date 10-31-07

Authorization to Construct by: date 5 June 07 Existing System Inspection by: date

HEALTH DEPT. COPY: WHITE OWNER COPY (FINAL): YELLOW OWNER COPY (INITIAL): PINK