IREDELL COUNTY HEALTH DEPARTMENT

STATESVILLE 704-878-5305 MOORESVILLE 704-664-5281

IMPROVEMENT PERMIT / AUTHORIZATION TO CONSTRUCT / OPERATION PERMIT / EXISTING SYSTEM INSPECTION

PERMIT# 07945 PIN# 4800 75 0364 DATE 3-3-99

OWNER OR CONTRACTOR GEORGE MASON PHONE: Business (336) 658-4122 Home

ADDRESS 121 ALMA DRIVE, STATESVILLE, NC 28625

LOCATION NC 115 N., TL DAMASCUS CH. RD, TR' CATTLEMAN'S RD, TL ALMA DRIVE, BEAR LEFT

SUBDIVISION BLOCK / SECTION LOT LOT AREA 5.00 ACRES SITE CLASS PS DESIGN FLOW 360' L.T.A.R. 0.30 GPD/FT²

Septic Tank: 1000 Gallons; STB 1012 Date 7-2-99
Pump Tank: Gallons; PT Date
Pump Make: Model Serial No.
Nitrification Field: No Fields 1 Square Feet 1200 Linear Feet 400
No Lines SIX Trench Width 36" Max Trench Bottom Depth 30" Gravel Depth 12"

✓ New System Repair System Type: I (II) III IV V VI
System Description: CONVENTIONAL, GRAVITY
Repair System Description: CONVENTIONAL GRAVITY
Maintenance Agreement Required: Yes ✓ No
Slab Crawl Space ✓ Basement w/plumbing Basement w/o plumbing


✓ House/Mod. Home No. Bedrooms 3
Mobile Home No. Bathrooms 3
Business No. Employees
Other

Water Supply: ✓ Individual Public Community WELL


Comments/Conditions: ① KEEP SYSTEM MINIMUM 100 FEET FROM WELL ② CONSTRUCT SUBSURFACE INTERCEPT DRAINAGE DITCH AT LOCATION SHOWN BEGINNING 42" DEEP OUT TO DAYLIGHT

Comments Conditions SEPTIC TANK W/ RISERS INSTALLED USING "POLYLOK" FILTER. SYSTEM INSTALLED ACCORDING TO INITIAL SITE SKETCH

INITIAL SITE SKETCH

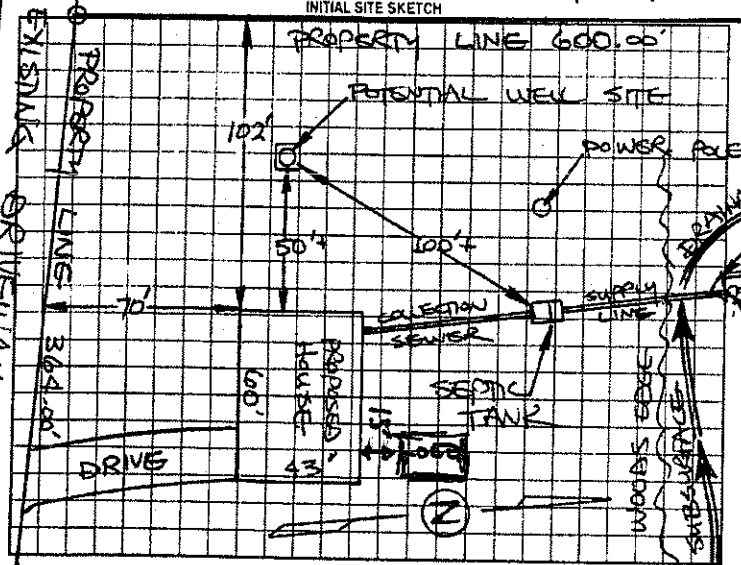

AS BUILT SKETCH

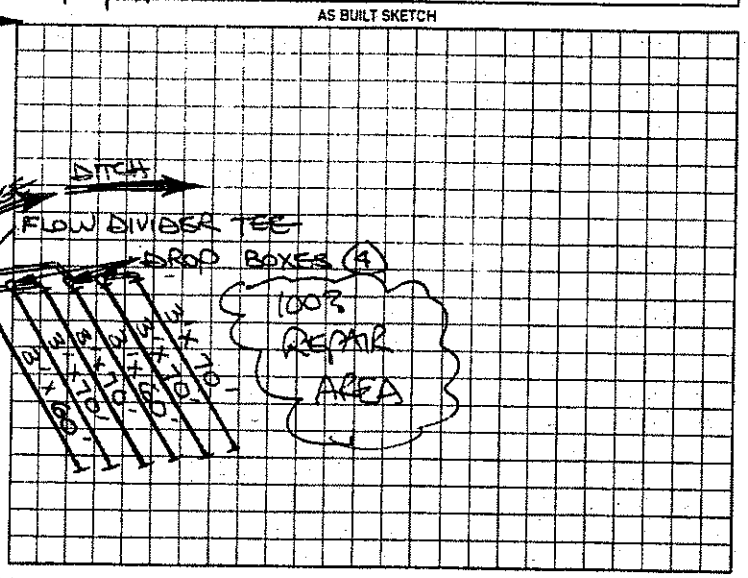

Permit can be suspended or revoked if any false information is supplied toward securing the permit/any unauthorized changes are made to the site/any unauthorized changes are made in the installation of the system. Improvement Permit with plat valid without expiration. Improvement Permit with site plan valid for sixty months. Authorization to Construct is valid for a period equal to that of Improvement Permit - not to exceed sixty months.

Signed: [signature] date 3-3-99

Improvement Permit by: STEVE HEDRICK date 3-3-99

Authorization to Construct by: STEVE HEDRICK date 3-3-99

Installed by: KENNY PEARSON

Operation Permit by: STEVE HEDRICK date 9-10-99

Existing System Inspection by: date

HEALTH DEPT. COPY WHITE OWNER COPY (FINAL) YELLOW OWNER COPY (INITIAL) PINK

Location of the proposed 14x33' swimming pool addition does not appear to impact the existing on-site septic system.NOTE:**

[signature] REHS

Date: 4-11-13

ICHD-Environmental Health Division