# IREDELL COUNTY HEALTH DEPARTMENT

STATESVILLE 704-878-5305 MOORESVILLE 704-664-5281

## IMPROVEMENT PERMIT / AUTHORIZATION TO CONSTRUCT / OPERATION PERMIT / EXISTING SYSTEM INSPECTION

PERMIT# 102785 PIN# 4800-77-2017 DATE 10-17-01

OWNER OR CONTRACTOR JONAS N. CAMPBELL PHONE: Business Home (704) 876-8760

ADDRESS 198 ALMA DR, STATESVILLE, NC 28625

LOCATION NC 115 N, TL DAMASCUS CH. RD, TR CATTLEMANS RD, TL ALMA DRIVE, TO END BEAR LEFT TO END

SUBDIVISION _____ BLOCK / SECTION _____ LOT _____ LOT AREA 1.11 ACRES SITE CLASS. PS DESIGN FLOW 240 L.T.A.R. EXISTING

Septic Tank: 1000 Gallons: STB _____ Date _____

Pump Tank: _____ Gallons: PT _____ Date _____

Pump Make: _____ Model _____ Serial No _____

Nitrification Field: No Fields 1 Square Feet 720 Linear Feet 240

No Lines TWO Trench Width 36" Max Trench Bottom Depth _____ Gravel Depth 12"

☐ New System ☐ Repair System Type: I (II) III IV V VI

System Description: CONVENTIONAL GRAVITY

Repair System Description: _____

Maintenance Agreement Required: ☐ Yes ☒ No

☐ House/Mod. Home No. Bedrooms 2

☒ Mobile Home No. Bathrooms 1

☐ Business No. Employees _____

☐ Other _____

☐ Slab ☒ Crawl Space ☐ Basement w/plumbing ☐ Basement wo/plumbing


Water Supply:
☒ Individual
☐ Public
☐ Community
WELL

Comments/Conditions:

Comments/Conditions:

INITIAL SITE SKETCH

AS BUILT SKETCH

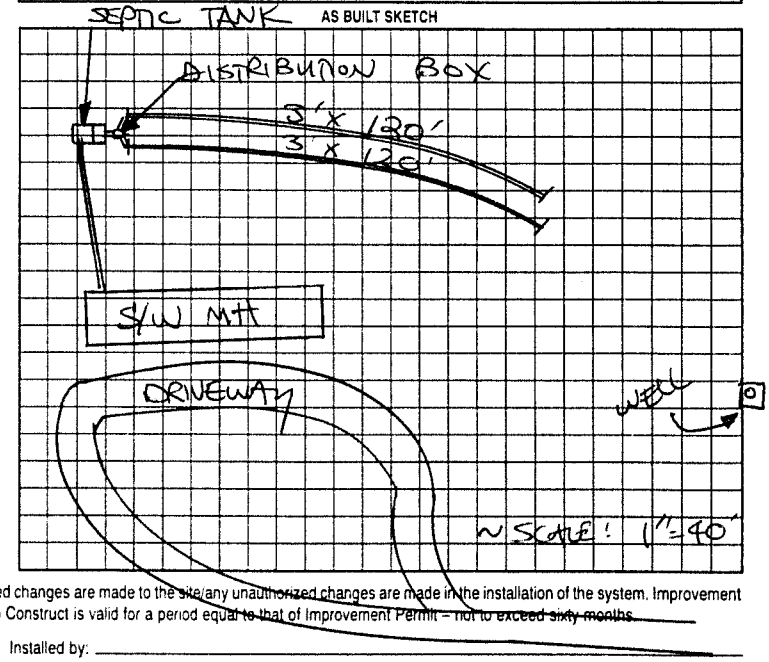


Permit can be suspended or revoked if any false information is supplied toward securing the permit/any unauthorized changes are made to the site/any unauthorized changes are made in the installation of the system. Improvement Permit with plat valid without expiration. Improvement Permit with site plan valid for sixty months. Authorization to Construct is valid for a period equal to that of Improvement Permit - not to exceed sixty months.

Signed: _____ date _____ Installed by: _____

Improvement Permit by: _____ date _____ Operation Permit by: _____ date _____

Authorization to Construct by: _____ date _____ Existing System Inspection by: STEVE HEDRICK date 10-17-01

HEALTH DEPT. COPY WHITE OWNER COPY (FINAL) YELLOW OWNER COPY (INITIAL) PINK