IREDELL COUNTY HEALTH DEPARTMENT

STATESVILLE 704-878-5305 MOORESVILLE 704-664-5281

53481

IMPROVEMENT PERMIT / CERTIFICATE OF COMPLETION / OPERATION PERMIT / EXISTING SYSTEM INSPECTION

PROPERTY DESCRIPTION NO. 18842 DATE 8/17/94 TAX MAP NO. 14K-A-83 Watershed: ☐ Yes ☑ No

OWNER OR CONTRACTOR J. DEAN GOODIN PHONE: Business 872-2771 Home

ADDRESS RT. 2, BOX 230-A HIDDENITE NC 28636

LOCATION NC 115 N, TL DAMASCUS CH. RD, TL HARNESS FARM RD, 1ST LOT ON (R)

SUBDIVISION BLOCK / SECTION LOT LOT AREA 1.9 AC SITE CLASS. P3 DESIGN FLOW 360 L.T.A.R. 0.30 GPD/FT²

Septic Tank: 1000 Gallons; STB 1012 Date 11/5/94

Pump Tank: Gallons; PT Date

Pump Make: Model Serial No.

Nitrification Field: No Fields 1 Square Feet 1200 Linear Feet 400

No Lines 3 Trench Width 36" Max Trench Bottom Depth 24"

☑ New System ☐ Repair System Type: I (II) III, IV, V, VI

System Description: CONVENTIONAL GRAVITY

Repair System Description: CONV. GRAVITY

Maintenance Agreement Required: ☐ Yes ☑ No

Gravel Depth 12"

☑ House/Mod. Home ☐ Mobile Home ☐ Business ☐ Other

No. Bedrooms 3 No. Bathrooms 3 No. Employees


☐ Slab ☐ Crawl Space ☐ Basement w/plumbing ☑ Basement wo/plumbing

Water Supply: ☑ Individual ☐ Community ☐ Public WELL

Comments: (1) KEEP SYSTEM MINIMUM 15' FROM BASEMENT, 10' FROM PROPERTY LINE, 100' FROM WELL (2) DRAINLINES SHALL BE INSTALLED ON CONTOUR USING SHALLOW PLACEMENT NO DEEPER THAN 24", 9' MINIMUM ON CENTER

Comments:

INITIAL SITE SKETCH

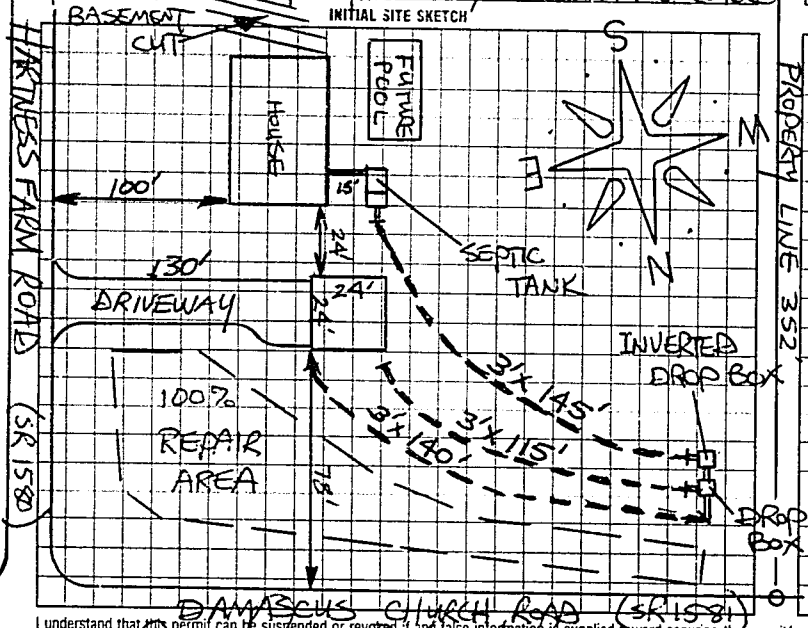

AS BUILT SKETCH

SYSTEM INSTALLED ACCORDING TO INITAL SITE SKETCH.

GARAGE AND DRIVEWAY RELOCATED TO SOUTH SIDE OF HOUSE.

I understand that this permit can be suspended or revoked if any false information is supplied toward securing the permit/any unauthorized changes are made to the site/any unauthorized changes are made in the installation of the system. Improvement Permit is valid for 60 months from date of issuance.

Signed: I. Jerry Dean Goodin

Improvement Permit by: STEVE HEDRICK date 8/17/94

Existing System Inspection by: date

Installed by: TOMMY FRYE

Certificate of Completion by: STEVE HEDRICK date 3/27/95

Operation Permit by: date

HEALTH DEPT. COPY: WHITE INSPECTION COPY (FINAL): GREEN OWNER COPY (FINAL): YELLOW INSPECTION COPY (INITIAL): PINK OWNER COPY (INITIAL): GOLD

0 8 Σ 0 0 0