IREDELL COUNTY HEALTH DEPARTMENT

STATESVILLE 704-878-5305 MOORESVILLE 704-664-5281

IMPROVEMENT PERMIT / AUTHORIZATION TO CONSTRUCT / OPERATION PERMIT / EXISTING SYSTEM INSPECTION

PERMIT# REPAIR PIN# 4800-82-8683 DATE 5-16-06

OWNER OR CONTRACTOR TIMOTHY C. GOODIN PHONE: Business Home 704-876-6952

ADDRESS 546 DAMASCUS CHURCH RD STATESVILLE NC 28625-9282

LOCATION NC 115 N TL DAMASCUS CHURCH RD, ON RIGHT AT BOX # 546

SUBDIVISION MINNIE BRAKEFIELD BLOCK / SECTION LOT 4 LOT AREA 1.88 ACRES SITE CLASS. PS DESIGN FLOW 240 L.T.A.R. 0.3 GPD/FT²

Septic Tank: EXISTING Gallons; STB Date

Pump Tank: Gallons; PT Date

Pump Make: Model 60.70 Serial No.

Nitrification Field: No Fields 1 Square Feet 720 Linear Feet 180

No Lines TWO Trench Width 36" Max Trench Bottom Depth 36" Gravel Depth N/A

☐ New System ☑ Repair System Type: (I) II, III, IV, V, VI

System Description:

Repair System Description: 25% REDUCTION, GRAVEL

Maintenance Agreement Required: ☐ Yes ☑ No

☑ House/Mod. Home No. Bedrooms 2

☐ Mobile Home No. Bathrooms

☐ Business No. Employees

☐ Other


☐ Slab ☐ Crawl Space ☑ Basement w/plumbing ☐ Basement wo/plumbing

Water Supply: ☑ Individual ☐ Public ☐ Community WELL

Comments:/Conditions: INTERSECT EXISTING DRAINLINE WITH NEW DROP BOX FEEDING TWO NEW DRAINLINES AS SHOWN ON CONTOUR. USE 25% REDUCTION SYSTEM FOR DRAINLINES.

Comments:/Conditions:

INITIAL SITE SKETCH

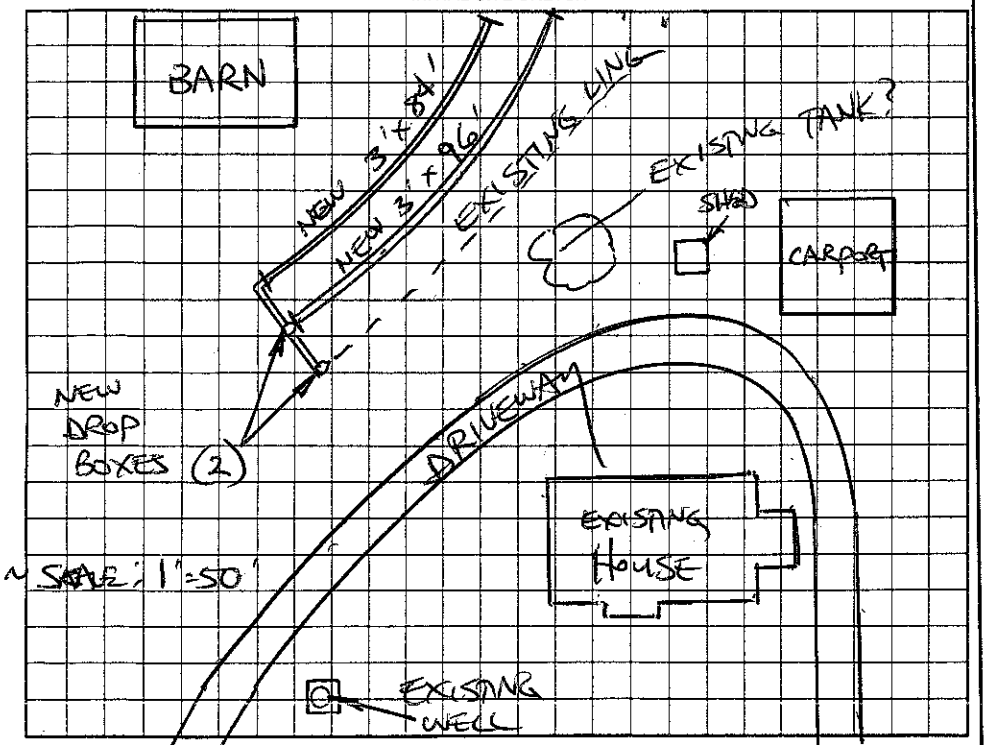

AS BUILT SKETCH

Permit can be suspended or revoked if any false information is supplied toward securing the permit/any unauthorized changes are made to the site/any unauthorized changes are made in the installation of the system. Improvement Permit with plat valid without expiration. Improvement Permit with site plan valid for sixty months. Authorization to Construct is valid for a period equal to that of Improvement Permit – not to exceed sixty months.

Signed: Donna Goodin date 5/16/06 Installed by: C & S Grading

Improvement Permit by: STEVE HENDRICK date 5-16-06 Operation Permit by: date 6-9-06

Authorization to Construct by: STEVE HENDRICK date 5-16-06 Existing System Inspection by: date

DAMASCUS CHURCH ROAD

HEALTH DEPT. COPY: WHITE OWNER COPY (FINAL): YELLOW OWNER COPY (INITIAL): PINK