IREDELL COUNTY HEALTH DEPARTMENT

Statesville Phone TR 3-7271 Mooresville Phone NO 3-1271

Permit NO. _____ PERMIT TO INSTALL SEPTIC TANK

Permit Date 5 30 1958

Owner R. E. Brakefield Address R2 N. Iredell

Installed By C Hoke Address R7


Location of Property Left at Zack Furney Store above central school cross line to new brick on L.

Tank		Capacity		Length of Lines		Fixtures	
Block	( )	800	(4)	150'	( )	No. of Baths	(1½)
Precast	(4)	900	( )	175'	( )	Dishwasher	( )
Lash		1000	( )	200'	( )	Garbage Grdr.	( )
		1100	( )	225'	(4)	Auto-Washer	( )
		1200	( )	250'	( )	Other	(4)
		Other _____		Other _____		Other _____	

NOTIFY HEALTH DEPARTMENT AT LEAST EIGHT HOURS BEFORE TANK IS TO BE INSPECTED.

Final Inspection 5 30 59 195_ Approved ( ) Disapproved ( )

Remarks Self Apply Pa TEH.

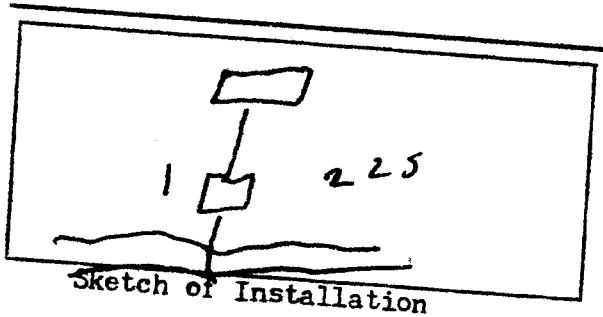

Sketch of Installation

R. H. L.

Sanitarian