IREDELL COUNTY HEALTH DEPARTMENT

STATESVILLE 704-878-5305 MOORESVILLE 704-664-5281

IMPROVEMENT PERMIT / AUTHORIZATION TO CONSTRUCT / OPERATION PERMIT / EXISTING SYSTEM INSPECTION

PERMIT # 160969 PIN # 4800-85-8433 DATE 6-8-10

OWNER or APPLICANT Arthur Chanel PHONE: Business 704 677 4942 Home:

OWNER or APPLICANT ADDRESS 5350 Catleman's Rd.

LOCATION / DIRECTIONS 115 N to Redmond's Central Store; left 1 mile on Mountain View, (L) on Catlemans; Prop on Right.

SUBDIVISION n/a BLOCK / SECTION n/a LOT # n/a LOT AREA 1.62 Ac. DESIGN FLOW 360 L.T.A.R. -3

Septic Tank 1000 Gallons: STB Date

Pump Tank Gallons: P T Date

Pump Make Model Serial #

Nitrification Field No Fields 1 No Lines 3 Linear Feet 133'

Trench Width 36" Max. Trench Bottom Depth 36" Gravel Depth n/a

☒ New System ☐ Repair ☐ Expansion System Type I (II) III IV V VI

System Description: Conventional Gravity

Repair System Description: Conventional Gravity

Maintenance Agreement Required ☐ YES ☒ NO

☒ GRAVITY ☐ PRESSURE

☒ Residence No. Bedrooms 3

☐ Business No. Persons

☐ Other No. Employees

☐ Slab ☒ Crawl Space

☐ Basement w/plumbing ☐ Basement w/o plumbing


Water Supply ☒ Private NEW ☐ Public ☐ Community

Comments / Conditions


An approved system may also be used

Comments / Conditions

INITIAL SITE SKETCH

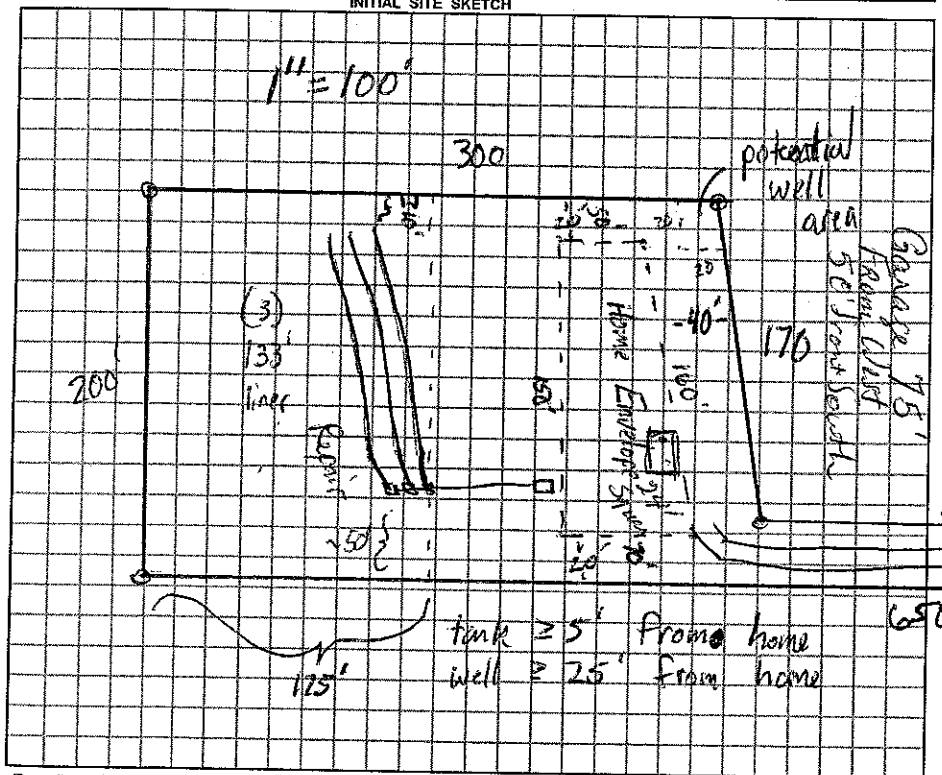

AS BUILT SKETCH

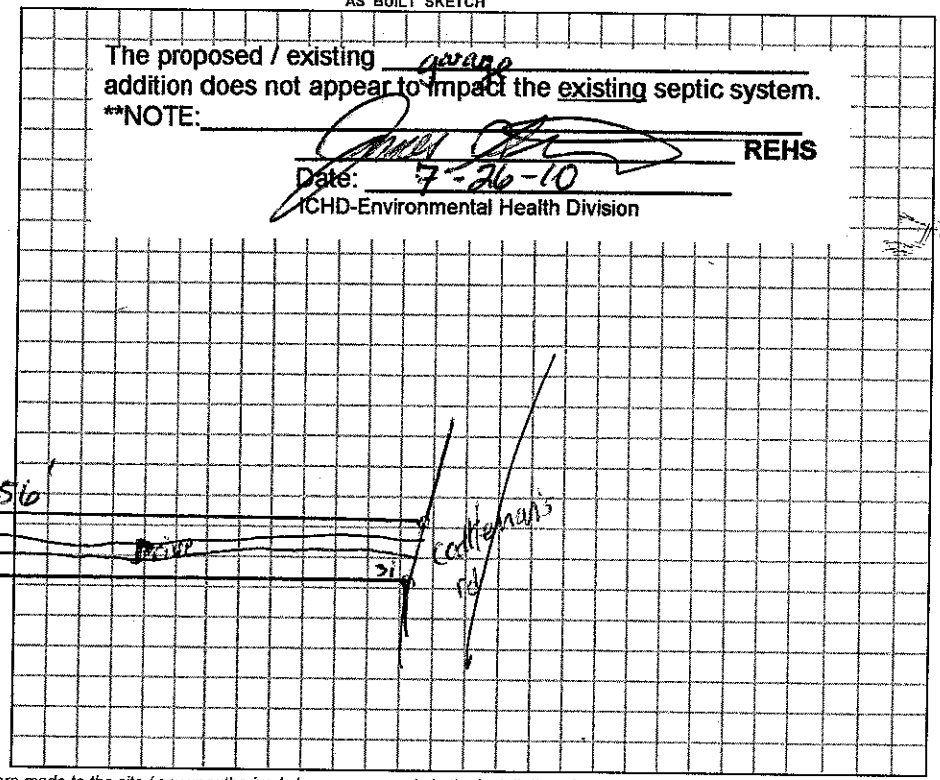

Permit can be suspended or revoked if any false information is supplied toward securing the permit / any unauthorized changes are made to the site / any unauthorized changes are made in the installation of the system.

☐ *IMPROVEMENT PERMIT w / plat valid without expiration* ☒ *IMPROVEMENT PERMIT w / site plan valid for 60 mos.*

☒ *AUTHORIZATION TO CONSTRUCT valid for period equal to IMPROVEMENT PERMIT-not to exceed 60 mo.*

Owner / Applicant Signature: Arthur W Chanel Date 6-9-10

Improvement Permit by: Date 6-8-10

Authorization to Construct by: Date 6-8-10

YOU SHOULD CONTACT A LOCATOR SERVICE PRIOR TO ANY EXCAVATION.

Installed by:

Operation Permit by: Date:

Existing System Inspected by: Date:

WHITE COPY Environmental Health YELLOW COPY (Final) Owner / Applicant PINK COPY (Initial) Owner / Applicant