10:30

IREDELL COUNTY HEALTH DEPARTMENT - *ENVIRONMENTAL HEALTH* ☑ STATESVILLE OFFICE 704-878-5305 ☐ MOORESVILLE OFFICE 704-664-5281

IMPROVEMENT PERMIT / AUTHORIZATION TO CONSTRUCT / OPERATION PERMIT / EXISTING SYSTEM INSPECTION

PERMIT # 170282 PIN # 4800-92-4311 DATE 31 January 2012

OWNER Chad Hartness APPLICANT: Freedom Homes PHONE: Home/Cell # (704) 883-6148 Business #

SITE ADDRESS 523 Damascus Church Rd, Stat. OWNER / APPLICANT ADDRESS

SITE DIRECTIONS 115N TL Damascus Ch. Rd. Cross Creek- 6m to top of hill - site on left.

SUBDIVISION BLOCK / SECTION LOT # LOT AREA 0.65Ac. DESIGN FLOW 360gpd L.T.A.R. 0.3g/ft²d

Septic Tank 1000 Gallons: STB 760 Date 7-2-11

Pump Tank Gallons: P T Date

Pump Make Model Serial #

No. Nitrification Fields: 1 No. Lines 4 Linear Feet 300

Trench Width 36" Max. Trench Bottom Depth 36" Gravel Depth NA

☑ New System ☐ Repair ☐ Expansion System Type I II III IV V VI

System Description: 25% Reduction System

Repair System Description: 25% Reduction System

Maintenance Agreement Required ☐ YES ☑ NO

☑ GRAVITY ☐ PRESSURE

☑ Residence No. Bedrooms 3

☐ Business No. Persons

☐ Other No. Employees


☐ Slab ☑ Crawl Space

☐ Basement w/plumbing ☐ Basement w/o plumbing


Water Supply: ☑ Private Exist off-site ☐ Public ☐ Community

Comments / Conditions: Follow contour

INITIAL SITE SKETCH

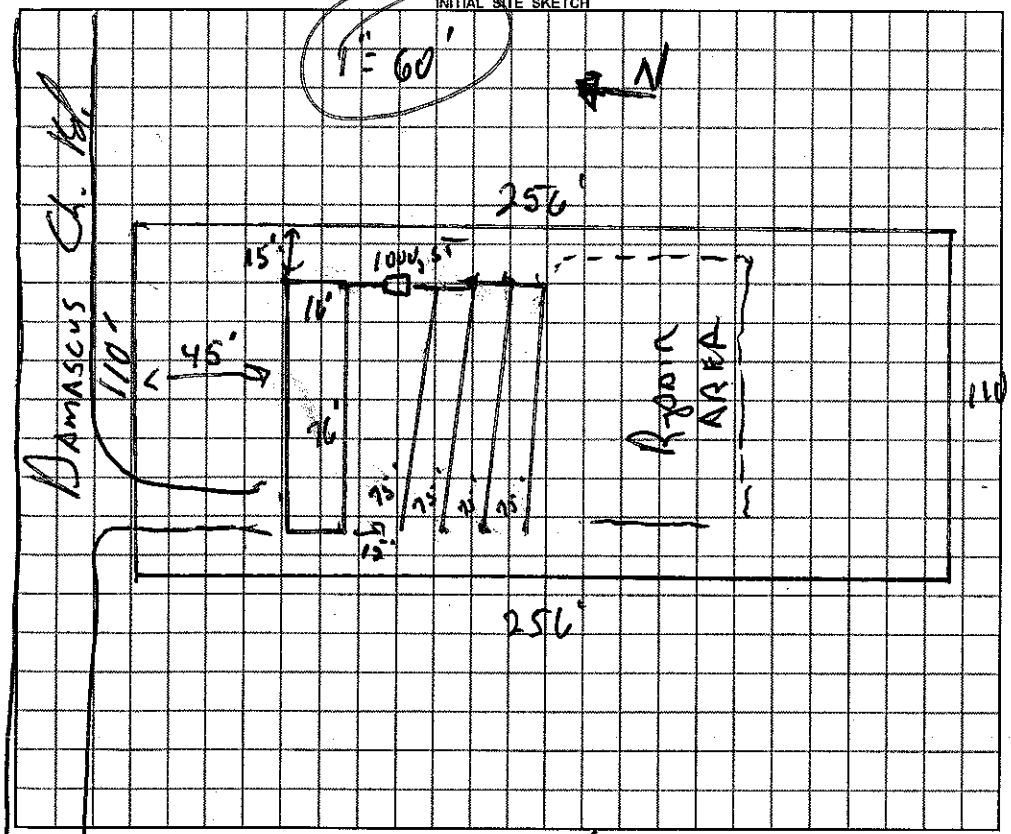

AS BUILT SKETCH

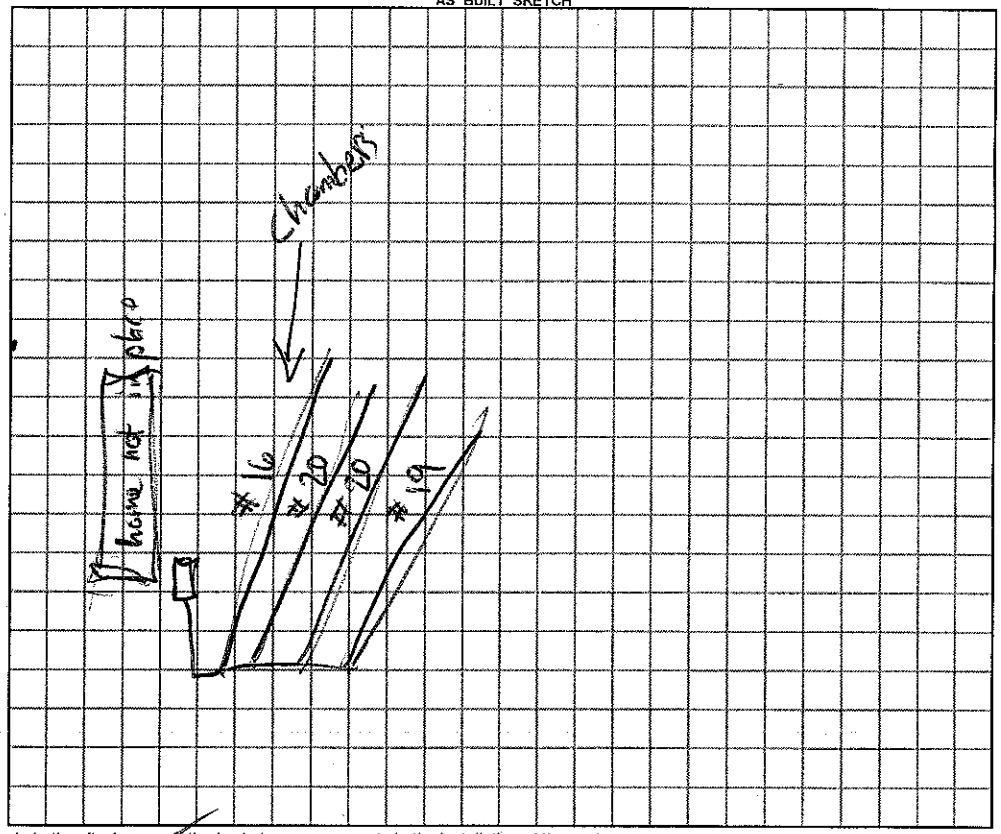

Permit can be suspended or revoked if any false information is supplied toward securing the permit / any unauthorized changes are made to the site / any unauthorized changes are made in the installation of the system.

☐ *IMPROVEMENT PERMIT with plat valid without expiration.* ☑ *IMPROVEMENT PERMIT with ~~plat valid without expiration.~~ site plan valid 60 mo.* ☑ *AUTHORIZATION TO CONSTRUCT* valid for period equal to IMPROVEMENT PERMIT--not to exceed 60 mo.

Owner / Applicant Signature: Date 31-Jan-12 Installed by: A-1 Backhoe

IMPROVEMENT PERMIT by: REHS Date 31 Jan. 12 OPERATION PERMIT by: REHS Date 2-1-12

AUTHORIZATION TO CONSTRUCT by: REHS Date 31 JAN 12 Existing System Inspected by: REHS Date

YOU SHOULD CONTACT A LOCATOR SERVICE PRIOR TO ANY EXCAVATION

White Copy – Environmental Health YELLOW COPY (Final) Owner / Applicant PINK COPY (Initial) Owner / Applicant