IREDELL COUNTY HEALTH DEPARTMENT

Statesville Office (704) 878-5305 Mooresville Office (704) 660-3625

IMPROVEMENT PERMIT / AUTHORIZATION TO CONSTRUCT / OPERATION PERMIT / EXISTING SYSTEM

PERMIT # 200595

APPLICANT: Abee's Clearing & Grading

PIN # 4801648555

SITE ADDRESS: 271 Clanton Rd.

APPLICANT ADDRESS: 2381 US Highway 64 West

SITE DIRECTIONS: HWY 115 N TL Mountain View Rd TL Clanton Rd.

PHONE: 704-239-3693 ALT. PHONE: N/A

SUBDIVISION: N/A

SECTION: N/A LOT # N/A LOT AREA: 0.8 acres DESIGN FLOW: 360 gpd L.T.A.R.: 0.275

Septic Tank	1000 (gal)	STB	760-1000	Date	3-16
Pump Tank	(gal)	PT		Date	
Pump Make		Model		Serial #	
# Nitrification Fields	1	# Lines	3	Linear Ft:	328
Trench Width	36"	Max. Trench Bottom Depth	27"	Gravel Depth	N/A

☑ New System ☐ Repair ☐ Expansion System Type: I II III IV V VI

System Description: 25% Reduction

Repair System Description: 25% Reduction

Maintenance Agreement Required: ☐ YES ☑ NO

☑ GRAVITY ☐ PRESSURE

☑ Residence ☐ Business ☐ Other ☐ Slab ☐ Basement w/plumbing


No. Bedrooms 3 No. Persons 6 No. Employees ☑ Crawl Space

Water Supply: ☐ Private ☐ Public ☑ Community

☐ Basement w/o plumbing

Comments / Conditions: Install a 25% Reduction system on contour with serial distribution. Maximum trench bottom is 27" on high side of trench.

INITIAL SITE SKETCH

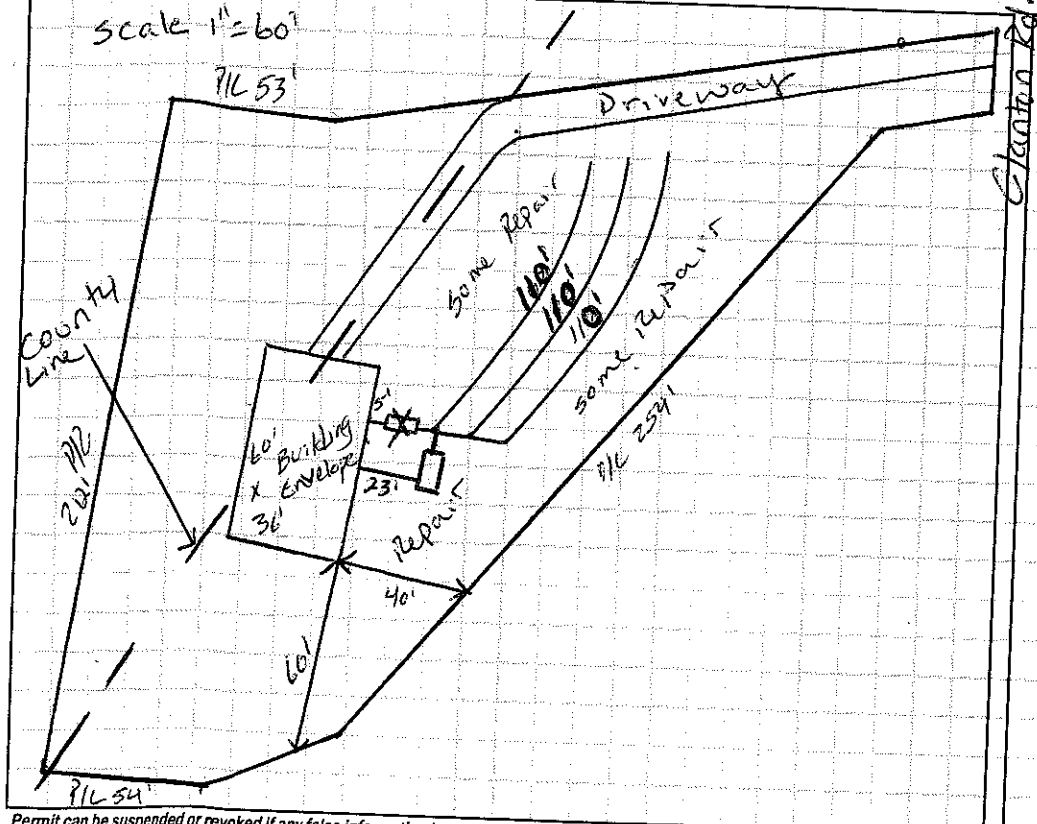

AS BUILT SKETCH

- Red Polylok filter installed
- ARC36 Chambers installed.
- Installed as drawn

Permit can be suspended or revoked if any false information is supplied toward securing the permit / any unauthorized changes are made to the site / any unauthorized changes are made in the installation of the system. **CONTACT A LOCATOR SERVICE PRIOR TO ANY EXCAVATION**

☐ **IMPROVEMENT PERMIT** *with plat valid without expiration.* ☑ **IMPROVEMENT PERMIT** *with site plan valid for 60 mos.* ☑ **AUTHORIZATION TO CONSTRUCT** *valid for period equal to IMPROVEMENT PERMIT--not to exceed 60 mo.*

Owner / Applicant Signature: Deena Abee Date: 2/26/14 Installed by: Tim Abee

IMPROVEMENT PERMIT by: Justin Henderson Date: 2-24-14 OPERATION PERMIT by: Justin Henderson Date: 7-11-14

AUTHORIZATION TO CONSTRUCT by: Justin Henderson Date: 2-24-14 Existing System Inspected by: Date:

Health Dept. Copy - WHITE Applicant (Final Approval) - YELLOW Applicant (Conditional Approval) - PINK