Robert Messer site address: 240 Clanton Rd. - Stat.

IREDELL COUNTY HEALTH DEPARTMENT

STATESVILLE 704-878-5305 (C1) MOORESVILLE 704-664-5281

IMPROVEMENT PERMIT / AUTHORIZATION TO CONSTRUCT / OPERATION PERMIT / EXISTING SYSTEM INSPECTION

(E1)

PERMIT# 110146 PIN# 4801-74-~~3357.8~~ 3222 DATE 11-27-02

OWNER OR CONTRACTOR FLEETWOOD HOMES PHONE: Business 704-528-7126 Home

ADDRESS 1040 CHARLOTTE HWY, TROUTMAN, NC 28166

LOCATION NC 115 N, TL MOUNTAIN VIEW ROAD, TL CLANTON ROAD, 0.1 MILE ON LEFT

SUBDIVISION BLOCK / SECTION LOT LOT AREA 1.0 ACRE SITE CLASS. PS DESIGN FLOW 360 L.T.A.R. 0.50 GPD/FT²

Septic Tank: 1000 Gallons; STB 1012 Date 8-3-02
Pump Tank: Gallons; PT Date
Pump Make: Model Serial No.
Nitrification Field: No Fields 1 Square Feet 720 Linear Feet 240
No Lines TWO Trench Width 36" Max Trench Bottom Depth 36" Gravel Depth 12"

☑ New System ☐ Repair System Type: I (II) III. IV. V. VI
System Description: CONVENTIONAL, GRAVITY
Repair System Description: CONVENTIONAL, GRAVITY
Maintenance Agreement Required: ☐ Yes ☐ No

☐ House/Mod. Home ☑ Mobile Home ☐ Business ☐ Other
No. Bedrooms 3 No. Bathrooms 2 No. Employees


☐ Slab ☑ Crawl Space ☐ Basement w/plumbing ☐ Basement wo/plumbing

Water Supply: ☑ Individual ☐ Public ☐ Community
WELL

Comments:/Conditions: KEEP SYSTEM MINIMUM 100 FEET FROM WELL (15A NCAC 18A .1956 (6)(9))

Comments:/Conditions: SEPTIC TANK WITH MARKER INSTALLED USING "TUFTITE" FILTER

INITIAL SITE SKETCH

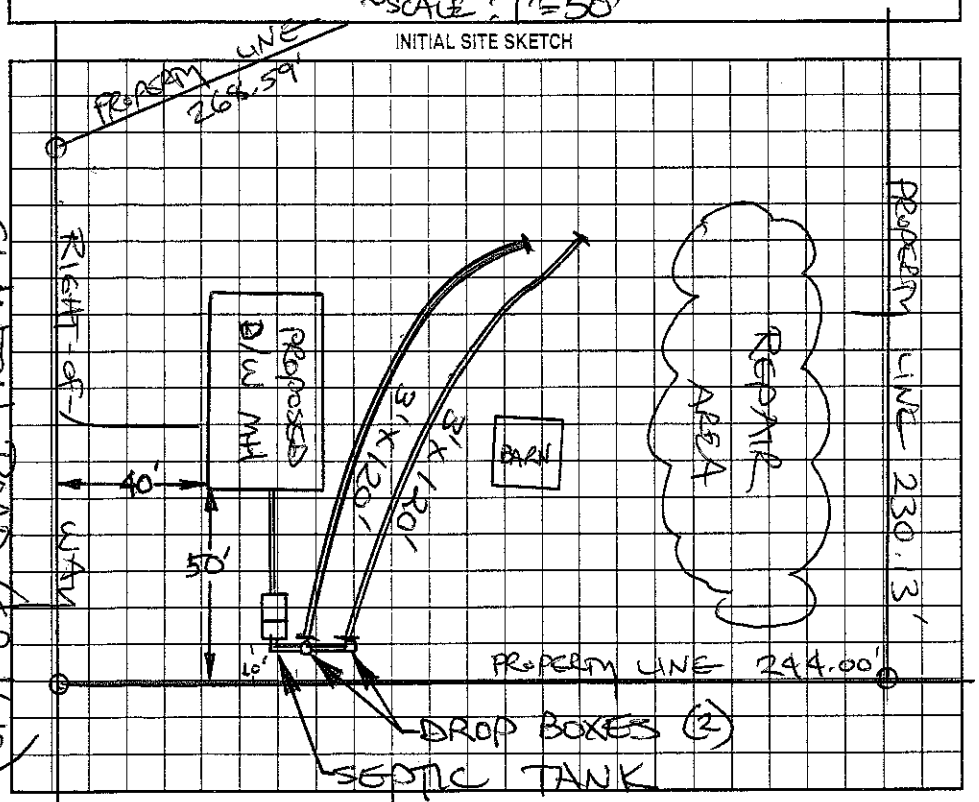

AS BUILT SKETCH

SYSTEM INSTALLED ACCORDING TO INITIAL SITE SKETCH

Permit can be suspended or revoked if any false information is supplied toward securing the permit/any unauthorized changes are made to the site/any unauthorized changes are made in the installation of the system. Improvement Permit with plat valid without expiration. Improvement Permit with site plan valid for sixty months. Authorization to Construct is valid for a period equal to that of Improvement Permit – not to exceed sixty months.

Signed: [signature] date 11-27-02 Installed by: CRAIG THOMPSON

Improvement Permit by: STEVE HEDRICK date 11-27-02 Operation Permit by: STEVE HEDRICK date 3-11-03

Authorization to Construct by: STEVE HEDRICK date 11-27-02 Existing System Inspection by: date

HEALTH DEPT. COPY: WHITE OWNER COPY (FINAL): YELLOW OWNER COPY (INITIAL): PINK