IREDELL COUNTY HEALTH DEPARTMENT

STATESVILLE 704-878-5305 MOORESVILLE 704-664-5281

IMPROVEMENT PERMIT / AUTHORIZATION TO CONSTRUCT / OPERATION PERMIT / EXISTING SYSTEM INSPECTION

PERMIT# 088003 PIN# 4801-78-5019 DATE 3-6-00

OWNER OR CONTRACTOR PAUL E. HOUSTON PHONE: Business Home 528-6274

ADDRESS P.O. BOX 658, TROUTMAN, NC, 28166

LOCATION NC 115 NORTH, TL MTN. VIEW ROAD, TR BACON ROAD, 0.6 MILE ON RIGHT

SUBDIVISION BLOCK / SECTION LOT LOT AREA 6.88 ACRES SITE CLASS PS DESIGN FLOW 240 L.T.A.R. 0.33 GPD/FT²

Septic Tank: 1000 Gallons; STB 1007 Date 4-4-00
Pump Tank: Gallons; PT Date
Pump Make: Model Serial No.
Nitrification Field: No Fields 1 Square Feet 720 Linear Feet 240
No Lines FOUR Trench Width 36" Max Trench Bottom Depth 36" Gravel Depth 12"

☑ New System ☐ Repair System Type: (I) II III IV V VI
System Description: CONVENTIONAL GRAVITY
Repair System Description: CONV. GRAVITY
Maintenance Agreement Required: ☐ Yes ☑ No
☐ Slab ☑ Crawl Space ☐ Basement w/plumbing ☐ Basement wo/plumbing


☑ House/Mod. Home No. Bedrooms 2
☐ Mobile Home No. Bathrooms 2
☐ Business No. Employees
☐ Other

Water Supply: ☑ Individual ☐ Public ☐ Community
WELL

Comments:/Conditions:

Comments:/Conditions: SEPTIC TANK W/ MARKER INSTALLED USING "ZABEL" FILTER

INITIAL SITE SKETCH

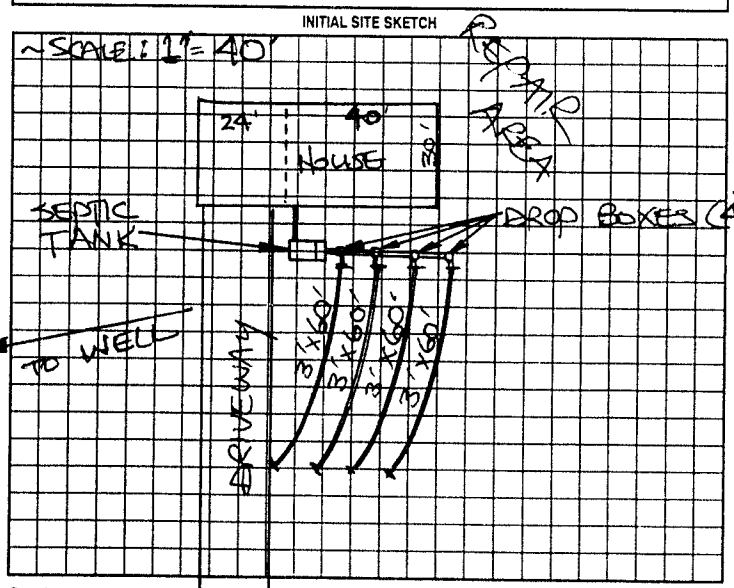

AS BUILT SKETCH

SYSTEM INSTALLED ACCORDING TO INITIAL SITE SKETCH

Permit can be suspended or revoked if any false information is supplied toward securing the permit/any unauthorized changes are made to the site/any unauthorized changes are made in the installation of the system. Improvement Permit with plat valid without expiration. Improvement Permit with site plan valid for sixty months. Authorization to Construct is valid for a period equal to that of Improvement Permit – not to exceed sixty months.

Signed: Paul E. Houston date 3-6-00 Installed by: SCOTT GREENE

Improvement Permit by: STEVE HEDRICK date 3-6-00 Operation Permit by: STEVE HEDRICK date 5-19-00

Authorization to Construct by: STEVE HEDRICK date 3-6-00 Existing System Inspection by: date

BACON ROAD (SR 1591)

HEALTH DEPT. COPY WHITE OWNER COPY (FINAL) YELLOW OWNER COPY (INITIAL) PINK