ICHD - ENVIRONMENTAL HEALTH DIVISION

Statesville Office (704) 878-5305 Mooresville Office (704) 660-3625 PERMIT # AP 2022-4909

SEPTIC: IMPROVEMENT PERMIT / AUTHORIZATION TO CONSTRUCT / OPERATION PERMIT / EXISTING SYSTEM

PIN # 4801 -- 81 -- 2940

APPLICANT/OWNER: Judy Kirby APPLICANT ADDRESS: 948 Brookhaven Rd, Statesville

SITE ADDRESS: 948 Brookhaven Rd, Statesville 28625 PHONE: 704-592-5528 ALT. PHONE -


SITE DIRECTIONS: 115 N - Mountain View - Brookhaven SAP CONTROLLED: ☐ YES ☐ NO

SUBDIVISION: - SECTION: - LOT # - LOT AREA: 18 acres DESIGN FLOW: EX L.T.A.R.: EX

Septic Tank 1000 (gal)	STB 760	Date 11/7/22	☐ New System ☒ Repair ☐ Expansion	System Type: I (II) III IV V VI	☒ Residence	No. Bedrooms EX	Water Supply
Pump Tank (gal)	PT	Date	System Description:		☐ Business	No. Persons EX	☒ Private
Pump Make	Model	Serial #	Repair System Description: Tank Replacement		☐ Other	No. Employees	☐ Public
# Nitrification Fields EX	# Lines EX	Linear Ft EX	Maintenance Agreement Required:	☐ YES ☒ NO	☐ Slab	☒ Crawl Space	☐ Community
Trench Width EX	Trench Bottom Depth(Low side) EX	Gravel Depth EX	☒ GRAVITY	☐ PRESSURE	☐ Basement w/plumbing	☐ Basement w/o plumbing	


Comments / Conditions: Pump, crush, & fill old septic tank. Replace distribution if necessary.

INITIAL SITE SKETCH

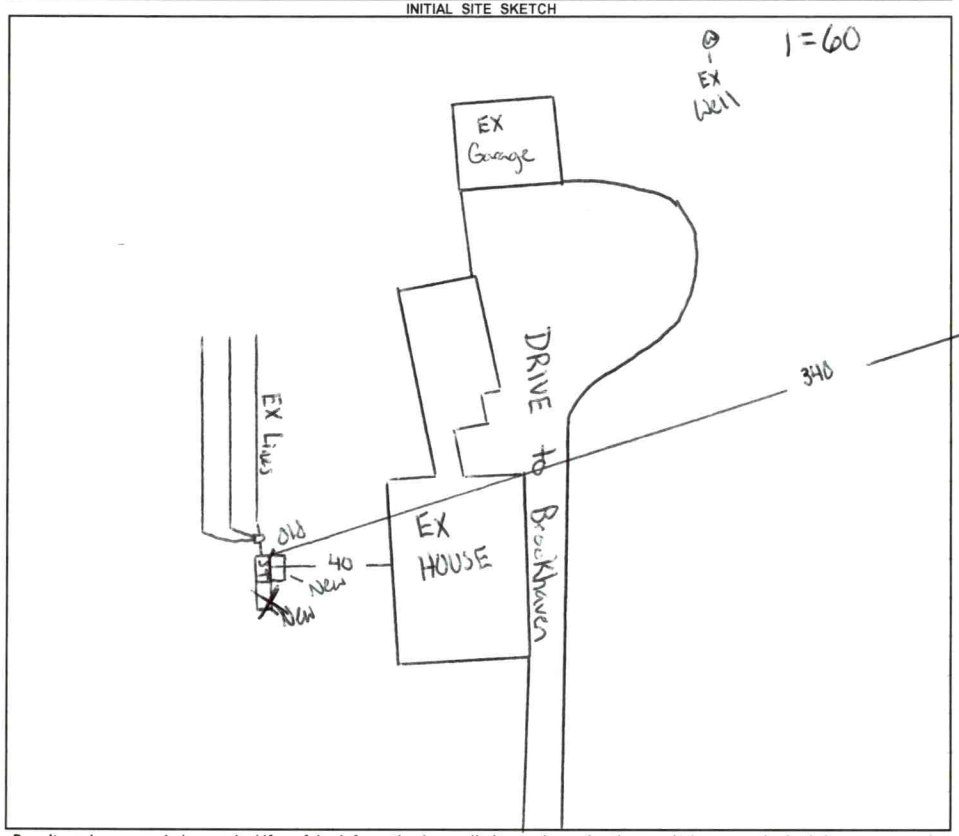

AS BUILT SKETCH

FOR SEPTIC FINAL INSPECTION CALL: 704-664-3703 between 8am-9am the day the inspection is needed. Be sure to speak with an inspector to confirm your time.

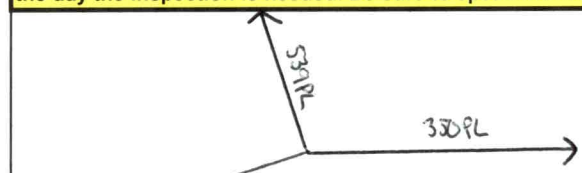

Installed as Drawn

Permit can be suspended or revoked if any false information is supplied toward securing the permit / any unauthorized changes are made to the site / any unauthorized changes are made in the installation of the system. **CONTACT A LOCATOR SERVICE PRIOR TO ANY EXCAVATION**

☐ **IMPROVEMENT PERMIT** ***with plat*** *valid without expiration.* ☒ **IMPROVEMENT PERMIT** ***with site plan*** *valid for 60 mos.* ☒ **AUTHORIZATION TO CONSTRUCT** *valid for period equal to IMPROVEMENT PERMIT--not to exceed 60 mo.*

Owner / Applicant Signature: 10-3-2022 Judy Kirby Date: 10-3-2022 Installed by: Jake Williams

IMPROVEMENT PERMIT by: Cory Whitt Date: 9/29/22 OPERATION PERMIT by: Cory Whitt Date: 12/22/22

AUTHORIZATION TO CONSTRUCT by: Cory Whitt Date: 9/29/22 Existing System Inspected by: Date:

FOR SEPTIC FINAL INSPECTION: CALL 704-664-3703 between 8am-9am the day the inspection is needed.

Item	Date	Initials
Drain Lines Checked		
Tanks Checked		
Pressure Manifold or Valve Box Checked		
Pressure Head Set		
Electrical Checked		
Floats Set		
Alarm Checked		
Maintenance Contract Needed? Y / N		
Comments:		

Repairs Only	
	State Code
Failing System Code	
Type of Distribution	G or P
Type of Failure/Malfunction	
Primary Cause of Failure/Malfunction	
Age of System? _____	
Initial or Repair? _____	