IREDELL COUNTY HEALTH DEPARTMENT

THIS PERMIT VOIDS PREVIOUS ISSUED 5/11/94 52206

STATESVILLE 704-878-5305 MOORESVILLE 704-664-5281

IMPROVEMENT PERMIT / CERTIFICATE OF COMPLETION / OPERATION PERMIT / EXISTING SYSTEM INSPECTION

PROPERTY DESCRIPTION NO. 8477 DATE 7/22/94 TAX MAP NO. 14M-A-137 Watershed: ☐ Yes ☒ No

OWNER OR CONTRACTOR DALE BRUCE PHONE: Business Home 876-1257

ADDRESS 112 VILLAGE DR, STVL NC 28677

LOCATION NC 115 N, TL MTN. VIEW RD, TL BROOKHAVEN RD, TL 2ND SHOEMAKER FARM ENTRANCE, 1ST MH LOT ON (L)

SUBDIVISION BLOCK / SECTION LOT LOT AREA 1.7 ACRES SITE CLASS. PS DESIGN FLOW 480 L.T.A.R. 0.40 GPD/FT2

Septic Tank: 1000 Gallons: STB 1012 Date NO DATE

Pump Tank: Gallons: PT Date

Pump Make: Model Serial No.

Nitrification Field: No Fields 1 Square Feet 1200 Linear Feet 400

No Lines 4 Trench Width 36" Max Trench Bottom Depth 18-36" Gravel Depth 12"

☒ New System ☐ Repair System Type: I, II, III, IV, V, VI

System Description: CONV. GRAVITY

Repair System Description: CONV. GRAVITY

Maintenance Agreement Required: ☐ Yes ☒ No

☐ House/Mod. Home No. Bedrooms 4

☒ Mobile Home No. Bathrooms 2

☐ Business No. Employees

☐ Other


☐ Slab ☒ Crawl Space ☐ Basement w/plumbing ☐ Basement wo/plumbing

Water Supply: ☒ Individual ☐ Community ☐ Public WELL

Comments: (1) KEEP SYSTEM MINIMUM 5' FROM MH, 10' FROM PROPERTY LINE, 100' FROM WELL (2) INSTALL LINES ON CONTOUR, NO DEEPER THAN 36" 9' MINIMUM ON CENTER (3) THIS PERMIT VOIDS PREVIOUS ISSUED 5/11/94

Comments:

INITIAL SITE SKETCH

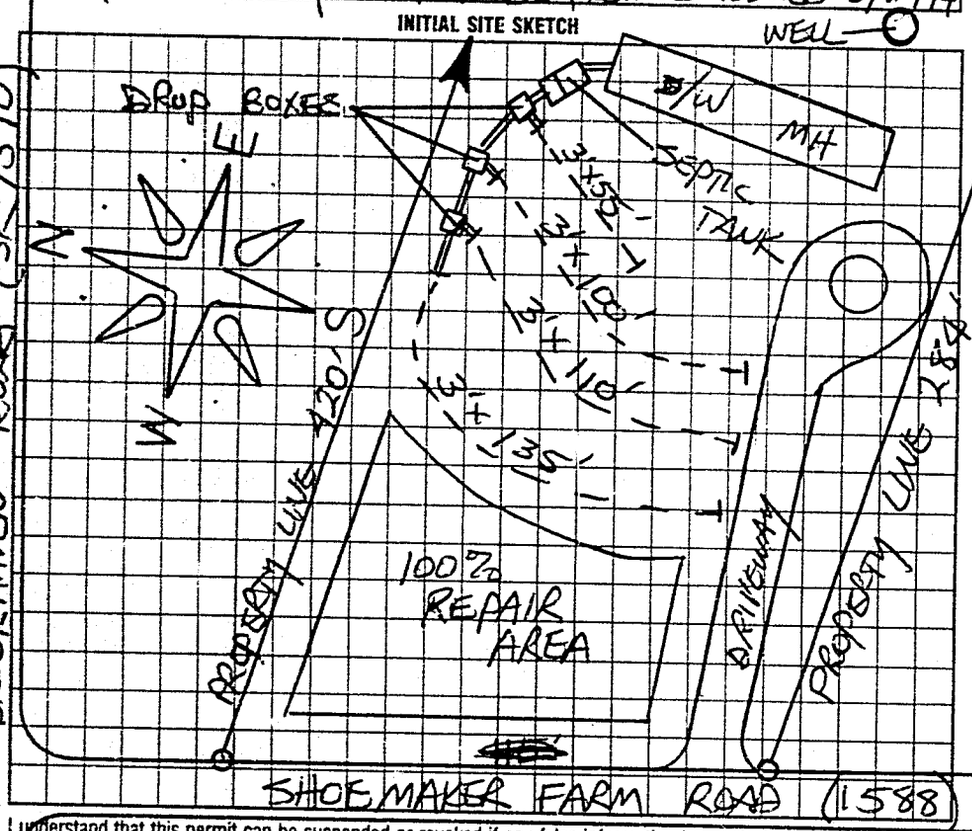

AS BUILT SKETCH

SYSTEM INSTALLED ACCORDING TO INITIAL SITE SKETCH

I understand that this permit can be suspended or revoked if any false information is supplied toward securing the permit/any unauthorized changes are made to the site/any unauthorized changes are made in the installation of the system. Improvement Permit is valid for 60 months from date of issuance.

Signed: Todd J. Brown

Improvement Permit by: STEVE HEDRICK date 7/22/94

Existing System Inspection by: date

Installed by: ANDY DANIELS.

Certificate of Completion by: STEVE HEDRICK date 8/10/94

Operation Permit by: date

HEALTH DEPT. COPY: WHITE INSPECTION COPY (FINAL): GREEN OWNER COPY (FINAL): YELLOW INSPECTION COPY (INITIAL): PINK OWNER COPY (INITIAL): GOLD