IREDELL COUNTY HEALTH DEPARTMENT - *ENVIRONMENTAL HEALTH* ☐ STATESVILLE OFFICE 704-878-5305 ☐ MOORESVILLE OFFICE 704-664-5281

IMPROVEMENT PERMIT / AUTHORIZATION TO CONSTRUCT / OPERATION PERMIT / EXISTING SYSTEM INSPECTION

PERMIT # 168995 PIN # 4801-86-5466 DATE 28 October 2011

OWNER Frances Mills APPLICANT: Penny A. Walker PHONE: Home/Cell # (704) 592-5046 Business #

SITE ADDRESS 172 Bacon Rd. (Love Valley) OWNER / APPLICANT ADDRESS

SITE DIRECTIONS 115 N TL Mountain View TR Bacon Rd. - on Rt. at bottom of hill

SUBDIVISION BLOCK / SECTION LOT # LOT AREA 9 Ac. DESIGN FLOW 360 gpd L.T.A.R. EX

Septic Tank EX Gallons: STB Date

Pump Tank Gallons: P T Date

Pump Make Model Serial #

No. Nitrification Fields: EX No. Lines EX Linear Feet EX

Trench Width EX Max. Trench Bottom Depth EX Gravel Depth EX

☐ EX New System ☐ Repair ☐ Expansion System Type I II III IV V VI

System Description: Ex. Conventional / trench

Repair System Description:

Maintenance Agreement Required ☐ YES ☐ NO

☑ GRAVITY ☐ PRESSURE


☑ Residence ☐ Business ☐ Other ☐ Slab ☐ Basement w/plumbing

No. Bedrooms 3 No. Persons No. Employees ☑ Crawl Space ☐ Basement w/o plumbing


Water Supply: ☑ Private ☐ Public ☐ Community

Comments / Conditions

INITIAL SITE SKETCH

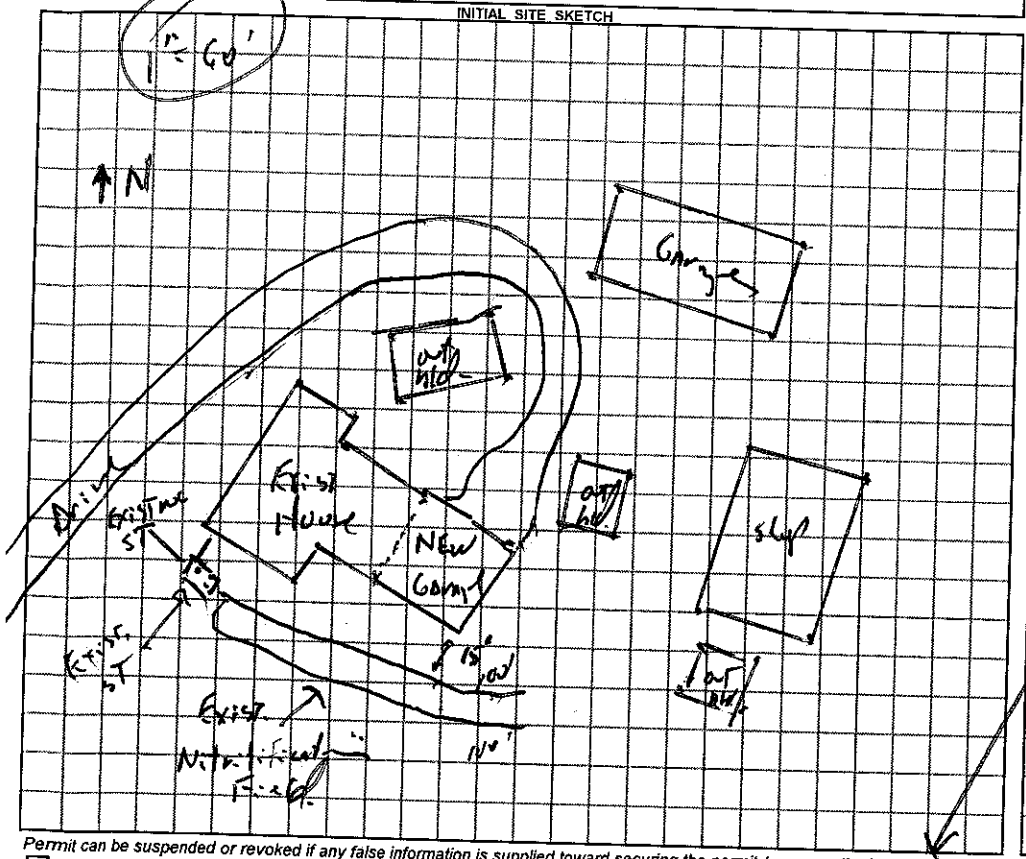

AS BUILT SKETCH

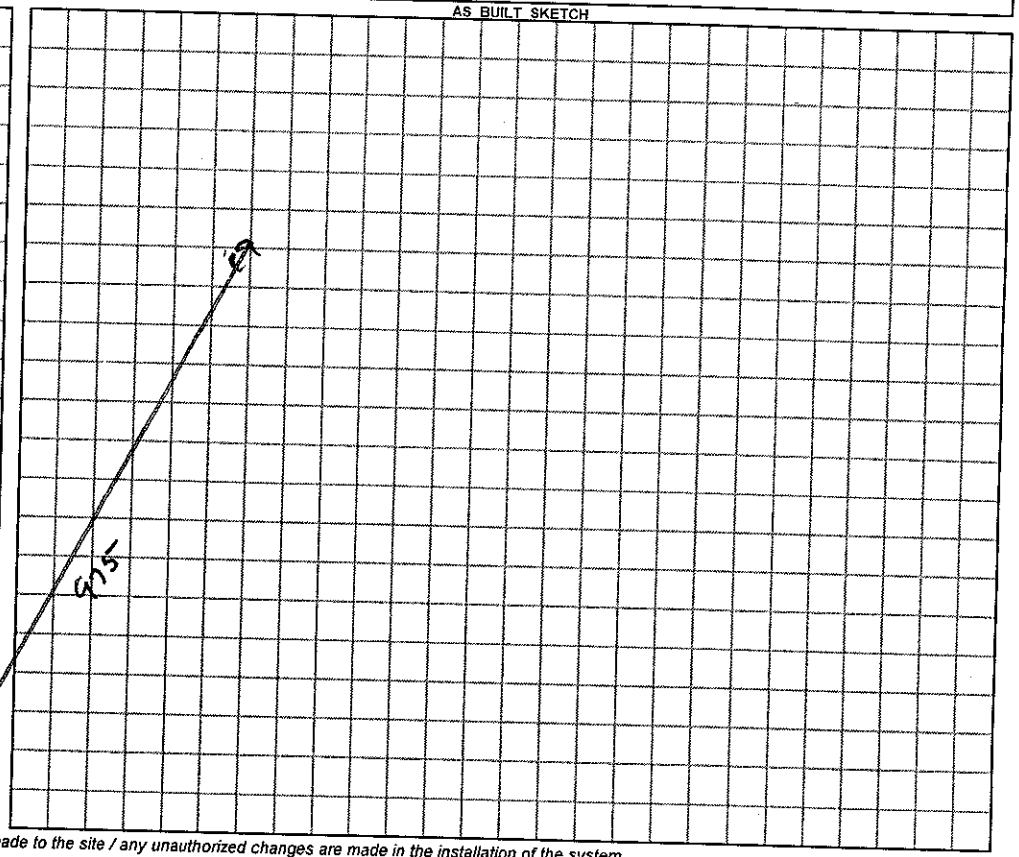

Permit can be suspended or revoked if any false information is supplied toward securing the permit / any unauthorized changes are made to the site / any unauthorized changes are made in the installation of the system.

☐ ***IMPROVEMENT PERMIT*** with plat valid without expiration. ☐ ***IMPROVEMENT PERMIT*** with ~~plat valid without expiration.~~ ***site plan valid 60 mo.*** ☐ ***AUTHORIZATION TO CONSTRUCT*** valid for period equal to IMPROVEMENT PERMIT--not to exceed 60 mo.

Owner / Applicant Signature: Penny A. Walker Date 10-28-11 Installed by:

IMPROVEMENT PERMIT by: REHS Date

AUTHORIZATION TO CONSTRUCT by: REHS Date

OPERATION PERMIT by: REHS Date

Existing System Inspected by: REHS Date 28 Oct. 11

YOU SHOULD CONTACT A LOCATOR SERVICE PRIOR TO ANY EXCAVATION

White Copy -- Environmental Health YELLOW COPY (Final) Owner / Applicant PINK COPY (Initial) Owner / Applicant