IREDELL COUNTY HEALTH DEPARTMENT

STATESVILLE 704-878-5305 MOORESVILLE 704-664-5281

IMPROVEMENT PERMIT / AUTHORIZATION TO CONSTRUCT / OPERATION PERMIT / EXISTING SYSTEM INSPECTION

PERMIT# 088374 PIN# 4811 07 0426 (PT) DATE 4-10-00

OWNER OR CONTRACTOR PAUL SPRINKLE PHONE: Business 662-8436 Home

ADDRESS P.O. BOX 1101 MOORESVILLE, NC 28115

LOCATION NC 115 N, TL MTN. VIEW RD, TR LOVE VALLEY RD, TL FOX MTN. RD, 0.4 MILE ON LEFT, 900' BACK

SUBDIVISION BLOCK / SECTION LOT LOT AREA 4.352 ACRES SITE CLASS PS DESIGN FLOW 480 L.T.A.R. 0.35 GPD/FT²

Septic Tank: 1000 Gallons: STB 1012 Date 1-8-2000
Pump Tank: Gallons: PT Date
Pump Make: Model Serial No.
Nitrification Field: No Fields 1 Square Feet 1380 Linear Feet 350
No Lines FOUR Trench Width 36" Max Trench Bottom Depth 36" Gravel Depth

☑ New System ☐ Repair System Type: I. II (III) IV. V. VI
System Description: 25% REDUCTION GRAVITY
Repair System Description: LOW PRESSURE PIPE
Maintenance Agreement Required: ☐ Yes ☑ No

☐ House/Mod. Home ☑ Mobile Home ☐ Business ☐ Other
No. Bedrooms 4 No. Bathrooms 2 No. Employees


☐ Slab ☑ Crawl Space ☐ Basement w/plumbing ☐ Basement wo/plumbing

Water Supply: ~~☑~~ Individual ☐ Public ☐ Community
WELL


Comments/Conditions: INSTALL 25% REDUCTION SYSTEM USING 58 (FIFTY-EIGHT) CHAMBERS USING "CONTOUR PANELS" TO ACCOMODATE BEDS OR 35 HDS SECTIONS ② KEEP SYSTEM MAXIMUM FROM WELL SITE.

Comments/Conditions: SEPTIC TANK W/ RISERS INSTALLED USING "POLYLOK." FILTER

INITIAL SITE SKETCH

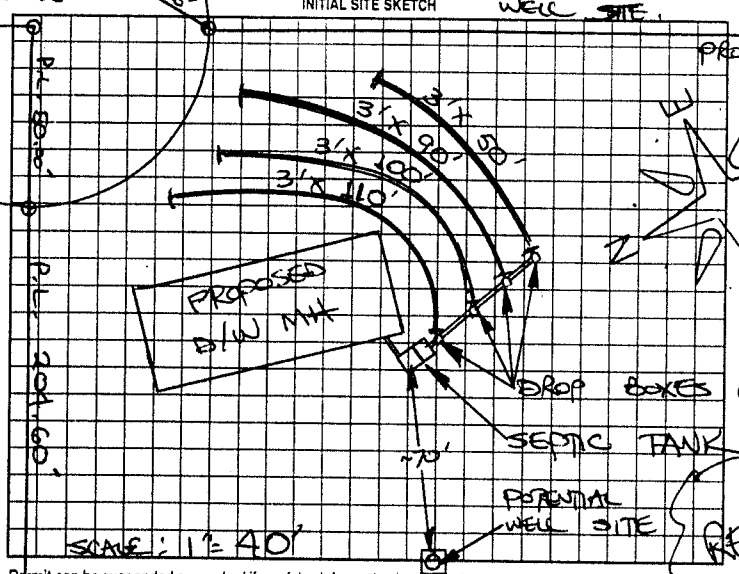

AS BUILT SKETCH

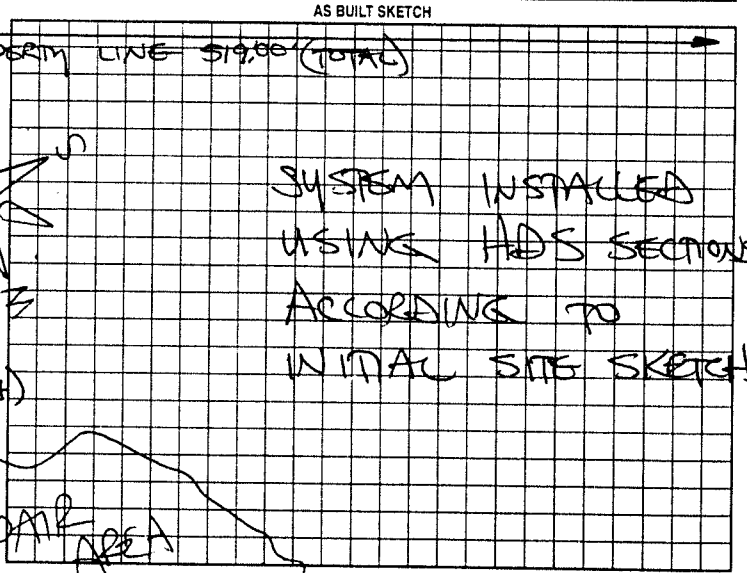

Permit can be suspended or revoked if any false information is supplied toward securing the permit/any unauthorized changes are made to the site/any unauthorized changes are made in the installation of the system. Improvement Permit with plat valid without expiration. Improvement Permit with site plan valid for sixty months. Authorization to Construct is valid for a period equal to that of Improvement Permit – not to exceed sixty months.

Signed: Paul Royal date 4-10-00 Installed by: A-1 BACKHOE

Improvement Permit by: STEVE HEDRICK date 4-10-00 Operation Permit by: STEVE HEDRICK date 4-12-00

Authorization to Construct by: STEVE HEDRICK date 4-10-00 Existing System Inspection by: date

HEALTH DEPT. COPY WHITE OWNER COPY (FINAL) YELLOW OWNER COPY (INITIAL) PINK