IREDELL COUNTY HEALTH DEPARTMENT

STATESVILLE 704-878-5305 MOORESVILLE 704-664-5281

IMPROVEMENT PERMIT / AUTHORIZATION TO CONSTRUCT / OPERATION PERMIT / EXISTING SYSTEM INSPECTION

PERMIT# 150107 PIN# 4801-88-0579 DATE 14 May 08

OWNER OR APPLICANT Robert Taylor PHONE: Business _____ Home 704-592-5410

ADDRESS 125 Taylor Pass Trail Statesville, N.C.

LOCATION Hwy 115 N Th Mountain View - TR into Love Valley Turn Fox Mtn. Rd. Turn ~~Right~~ Chevril Pass Cntr - Bottom Hill

SUBDIVISION Carusle Farm BLOCK / SECTION 2 LOT 3 LOT AREA 0.79ac. SITE CLASS. PS DESIGN FLOW 240 gpd L.T.A.R. 0.3 g/ft²/d

Septic Tank: 1000g Gallons; STB 1000-7 Date 2-25-08

Pump Tank: _____ Gallons; PT _____ Date _____

Pump Make: _____ Model _____ Serial No. _____

Nitrification Field: No Fields 1 Square Feet = 800 Linear Feet 200

No Lines 3 Trench Width 36" Max Trench Bottom Depth 36" Gravel Depth _____

☑ New System ☐ Repair ☐ Expansion System Type: I II (III) IV V VI

System Description: 25% Reduction

Repair System Description: 25% Reduction

Maintenance Agreement Required: ☐ Yes ☑ No

☐ Gravity ☐ Pressure

☐ House/Mod. Home ☑ Mobile Home ☐ Business ☐ Other

No. Bedrooms 2 No. Persons ____ No. Employees ____


Water Supply: ☐ Individual ☐ Public ☑ Community

☐ Slab ☑ Crawl Space ☐ Basement w/plumbing ☐ Basement wo/plumbing


Comments/Conditions: Follow contour with system. Honour all setback requirements.

Comments/Conditions: Filter Inside/Out

INITIAL SITE SKETCH

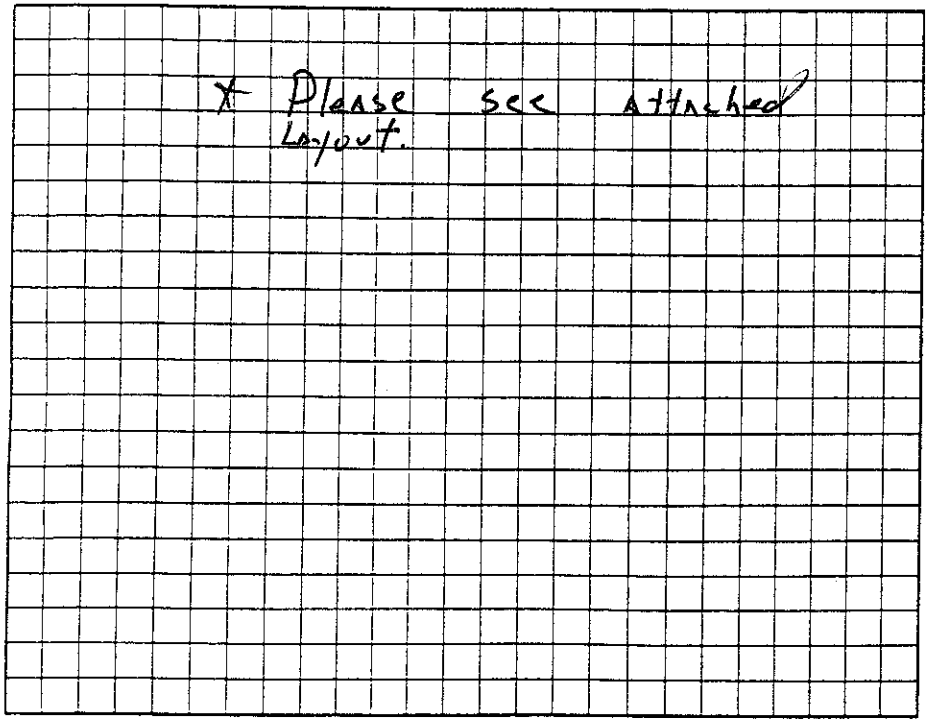

AS BUILT SKETCH

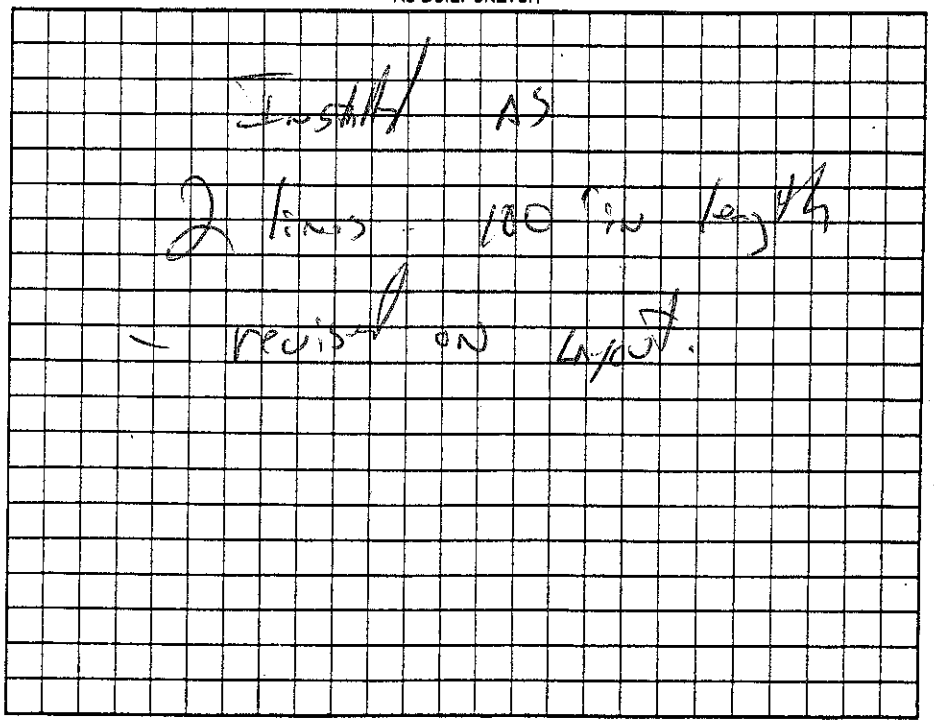


Permit can be suspended or revoked if any false information is supplied toward securing the permit/any unauthorized changes are made to the site/any unauthorized changes are made in the installation of the system. Improvement Permit with plan valid without expiration ☐ Improvement Permit with site plan valid for sixty months ☑ Authorization to Construct is valid for a period equal to that of Improvement Permit – not to exceed sixty months.

Signed: Robert C. Taylor date 5-15-08 Installed by: Randy Daniels

Improvement Permit by: _____, R.S. date 14 May 08 Operation Permit by: _____, R.S. date 2 June 08

Authorization to Construct by: _____, R.S. date 14 May 08 Existing System Inspection by: _____ date _____

HEALTH DEPT. COPY: WHITE OWNER COPY (FINAL): YELLOW OWNER COPY (INITIAL): PINK

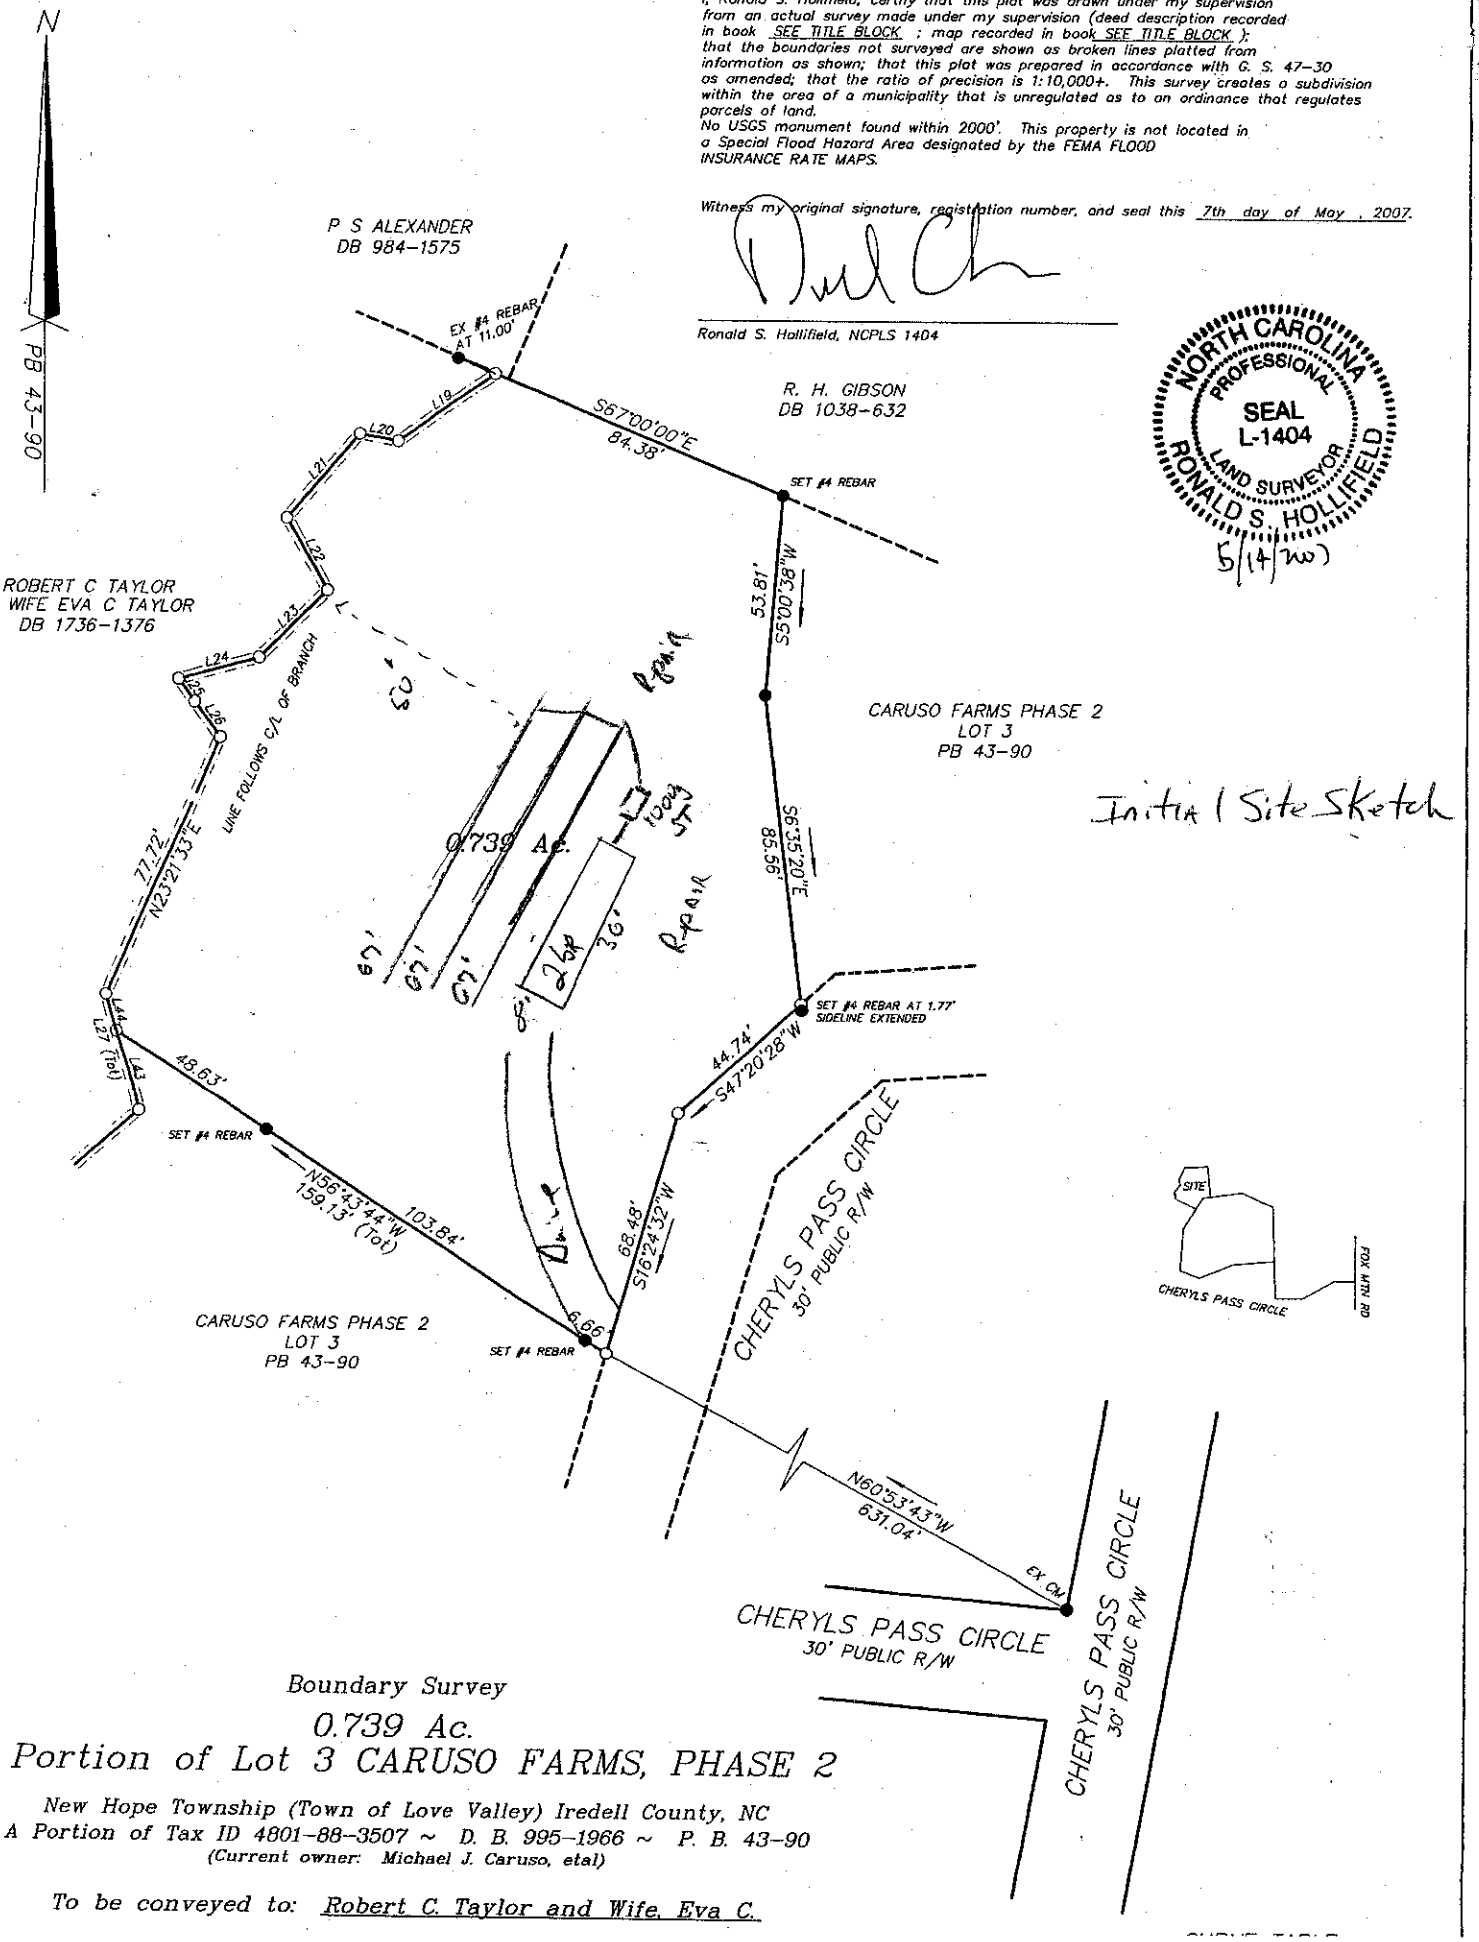

Boundary Survey

0.739 Ac.

A Portion of Lot 3 CARUSO FARMS, PHASE 2

New Hope Township (Town of Love Valley) Iredell County, NC
A Portion of Tax ID 4801-88-3507 ~ D. B. 995-1966 ~ P. B. 43-90
(Current owner: Michael J. Caruso, etal)

To be conveyed to: Robert C. Taylor and Wife, Eva C.