46909

IREDELL COUNTY HEALTH DEPARTMENT

STATESVILLE 704-878-5305 MOORESVILLE 704-664-5281

IMPROVEMENT PERMIT / CERTIFICATE OF COMPLETION / OPERATION PERMIT / EXISTING SYSTEM INSPECTION

PROPERTY DESCRIPTION NO. 16015 DATE 9/1/93 TAX MAP NO. 14M-A-123

OWNER OR CONTRACTOR REGGIE JOHNSON PHONE: Business Home

ADDRESS

LOCATION NC15N, TL MTN VIEW RD, TL BROOKHAVEN RD TL 2ND SHUMAKER LP, ON (L) ~0.2 MILE BACK

SUBDIVISION BLOCK / SECTION LOT LOT AREA 4.95 Ac SITE CLASS. PS 1 L.T.A.R. 0.35 GPD/FT²

Water Supply: ☑ Individual ☐ Community ☐ Public WELL

Septic Tank: 1000 Gallons; STB 760 Date 7/23/93

Pump Tank: Gallons; PT Date

Nitrification Field: No Fields 1 Square Feet 1035 Linear Feet 345

No Lines 6 Trench Width 36" Trench Depth ≤36" Gravel Depth 12"

☐ New System ☐ Repair System Type: I (II) III, V, VI

System Description: CONV, GRAVITY

Repair System Description: CONV, GRAVITY

Maintenance Agreement Required: ☐ Yes ☑ No

☐ House/Mod. Home No. Bedrooms 3

☐ Mobile Home No. Bathrooms 2

☐ Business No. Employees

☐ Other

Garbage Disposal: ☐ Yes ☑ No

Auto. Dishwasher: ☑ Yes ☐ No

Auto. Washing Machine: ☑ Yes ☐ No


Other

☐ Slab ☑ Crawl Space ☐ Basement w/plumbing ☐ Basement wo/plumbing

Comments SYSTEM INSTALLATION DIFFERENT FROM INITIAL LAYOUT DUE TO WELL PLACEMENT

INITIAL SITE SKETCH

AS BUILT SKETCH

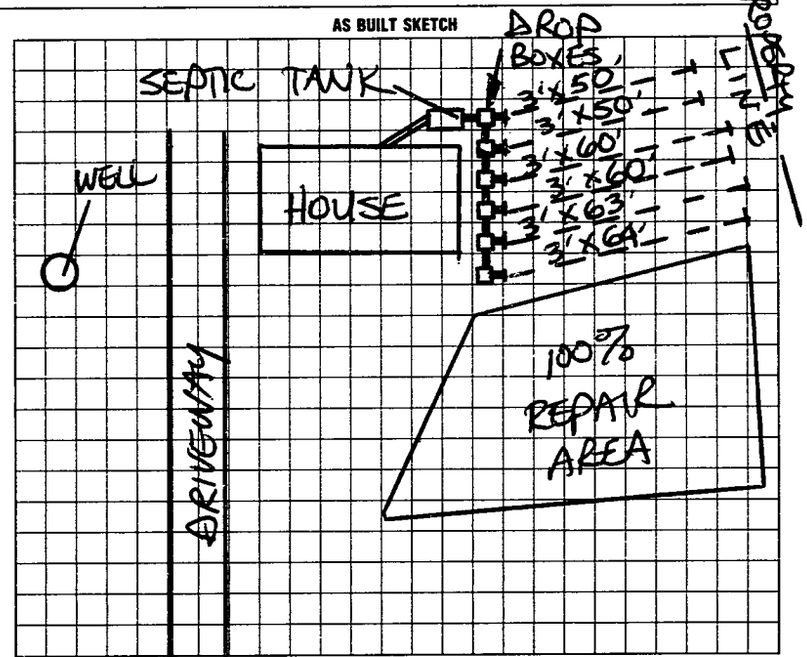

I understand that this permit can be suspended or revoked if any false information is supplied toward securing the permit/any unauthorized changes are made to the site/any unauthorized changes are made in the installation of the system. Improvement Permit is valid for 60 months from date of issuance.

Signed:

Improvement Permit by: STEVE HEDRICK date 3/24/93

Existing System Inspection by: date

Installed by: ROWAN SEPTIC TANK / GEORGE KIRKPATRICK

Certificate of Completion by: STEVE HEDRICK date 9/1/93

Operation Permit by: date

HEALTH DEPT. COPY: WHITE INSPECTION COPY (FINAL): GREEN OWNER COPY (FINAL): YELLOW INSPECTION COPY (INITIAL): PINK OWNER COPY (INITIAL): GOLD