IREDELL COUNTY HEALTH DEPARTMENT

THIS PERMIT VOIDS PREVIOUS ISSUED 6-27-94

STATESVILLE 704-878-5305 MOORESVILLE 704-664-5281

IMPROVEMENT PERMIT / AUTHORIZATION TO CONSTRUCT / OPERATION PERMIT / EXISTING SYSTEM INSPECTION

PERMIT# 19417 PIN# TAX MAP # 14M-A-A2 DATE 10-4-99

OWNER OR CONTRACTOR ROCKY HILL BAPTIST CHURCH PHONE: Business HAL JOLLY 592-7521 Home

ADDRESS RT. 2 BOX 217, MOUNTAIN VIEW ROAD, STATESVILLE, NC 28625

LOCATION NC 115 N, TL MOUNTAIN VIEW ROAD, CHURCH ON LEFT ACROSS FROM LOVE VALLEY ROAD

SUBDIVISION — BLOCK / SECTION LOT LOT AREA 6.631 ACRES SITE CLASS PS DESIGN FLOW 495 L.T.A.R. 0.33 gpd/ft²

Septic Tank: 1500 Gallons; STB 268 Date 9-10-99
Pump Tank: Gallons; PT Date
Pump Make: Model Serial No.
Nitrification Field: No Fields 1 Square Feet 1500 Linear Feet 500
No Lines FOUR Trench Width 36" Max Trench Bottom Depth 30"

☑ New System ☐ Repair System Type: I II (III) IV V VI
System Description: (TYPE 3A) CONVENTIONAL GRAVITY
Repair System Description: (TYPE 3A) CONV. GRAVITY
Maintenance Agreement Required: ☐ Yes ☑ No

Gravel Depth 12" ☑ Slab ☐ Crawl Space Basement w/plumbing Basement wo/plumbing


☐ House/Mod. Home No. Bedrooms —
☐ Mobile Home No. Bathrooms 2
☐ Business No. Employees —
☑ Other CHURCH W/330 SEATS @ 3gpd

Water Supply: ~~Individual~~ ☐ Public ☐ Community WELL

Comments/Conditions: ① INSTALL FOUR 3' x 125' CONVENTIONAL LINES ON CONTOUR AS FLAGGED ② KEEP SYSTEM MINIMUM 100 FEET FROM WELL

Comments/Conditions: SEPTIC TANK WITH RISERS INSTALLED USING "ZABEL" A-1800 FILTER

INITIAL SITE SKETCH

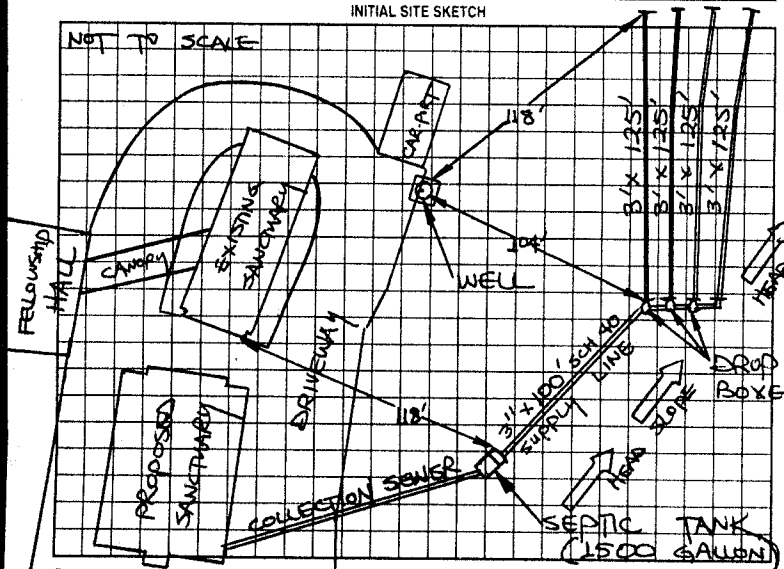

AS BUILT SKETCH

SYSTEM INSTALLED ACCORDING TO INITIAL SITE SKETCH

Permit can be suspended or revoked if any false information is supplied toward securing the permit/any unauthorized changes are made to the site/any unauthorized changes are made in the installation of the system. Improvement Permit with plat valid without expiration. Improvement Permit with site plan valid for sixty months. Authorization to Construct is valid for a period equal to that of Improvement Permit – not to exceed sixty months.

Signed: Hal D Jolly date 10 5 99 Installed by: JAMES HUNTER

Improvement Permit by: STEVE HEDRICK date 10-4-99 Operation Permit by: STEVE HEDRICK date 11-9-99

Authorization to Construct by: STEVE HEDRICK date 10-4-99 Existing System Inspection by: date

HEALTH DEPT COPY: WHITE OWNER COPY (FINAL): YELLOW OWNER COPY (INITIAL): PINK