IREDELL COUNTY HEALTH DEPARTMENT

Statesville Phone TR 3-7271 Mooresville Phone NO 3-1271

PERMIT TO INSTALL SEPTIC TANK

Permit NO. 278 Permit Date Aug 21 1970

Owner Rock Hill Baptist Church Address Rt. 2 Statesville, NC.

Installed By Hope Bros. + Coon. Help Address Statesville, N.C.


Location of Property North on 115. Left on Road #1614 near intersection of Road #1611

Tank		Capacity		Length of Lines		Fixtures	
Block	( )	1000	( )	225'	( )	No. of Baths	(2)
Precast	(✓)	1250	(✓)	250'	( )	Dishwasher	( )
		1500	( )	Other 300		Garbage Grdr.	( )
		Other				Other	

NOTIFY HEALTH DEPARTMENT AT LEAST EIGHT HOURS BEFORE TANK IS TO BE INSPECTED.

Final Inspection Aug 21 1970 Approved (✓) Disapproved ( )

Remarks

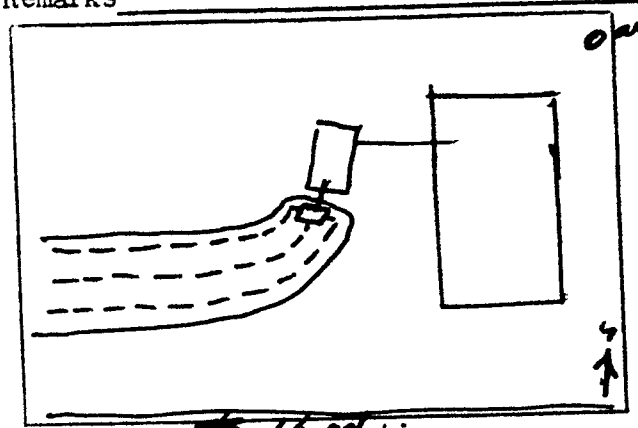

Sketch of Installation

Glenn Taylor

Sanitarian