# IREDELL COUNTY HEALTH DEPARTMENT

STATESVILLE 704-878-5305 MOORESVILLE 704-664-5281

## IMPROVEMENT PERMIT / AUTHORIZATION TO CONSTRUCT / OPERATION PERMIT / EXISTING SYSTEM INSPECTION

PERMIT# Love Valley PIN# 4801-88-4250 4801-97-0999 DATE 6-26-03

OWNER OR CONTRACTOR MIKE CARUSO PHONE: Business Home 704-592-5517

ADDRESS 279 LOVE VALLEY ROAD, LOVE VALLEY NC 28625

LOCATION NC 115 N TL MTN. VIEW RD, TR LOVE VALLEY RD TL FOX MOUNTAIN RD TL CHERYL'S PASS CIRCLE

SUBDIVISION CARUSO FARMS BLOCK / SECTION 2 LOT 3 LOT AREA ACREAGE SITE CLASS. PS DESIGN FLOW 240 L.T.A.R. 0.30 GPD/FT2

Septic Tank: 1000 Gallons; STB 1012 Date 8-29-03

Pump Tank: ____ Gallons; PT ____ Date ____

Pump Make: ____ Model ____ Serial No. ____

Nitrification Field: No Fields 1 Square Feet 810 Linear Feet 270

No Lines FOUR Trench Width 36" Max Trench Bottom Depth 36" Gravel Depth 12"

☑ New System ☐ Repair System Type: I (II) III, IV, V, VI

System Description: CONVENTIONAL, GRAVITY

Repair System Description: CONVENTIONAL, GRAVITY

Maintenance Agreement Required: ☐ Yes ☑ No

☑ House/Mod. Home No. Bedrooms 2

☑ Mobile Home No. Bathrooms 1

☐ Business No. Employees ____

☐ Other ____


☑ Slab ☐ Crawl Space ☐ Basement w/plumbing ☐ Basement wo/plumbing

Water Supply: ☑ Individual ☐ Public ☐ Community WELL

Comments:/Conditions: DROP BOXES (4)

Comments:/Conditions: ① TUFF-TITE FILTER ② #57 STONE ③ INSTALLED ACCORDING TO SKETCH

INITIAL SITE SKETCH

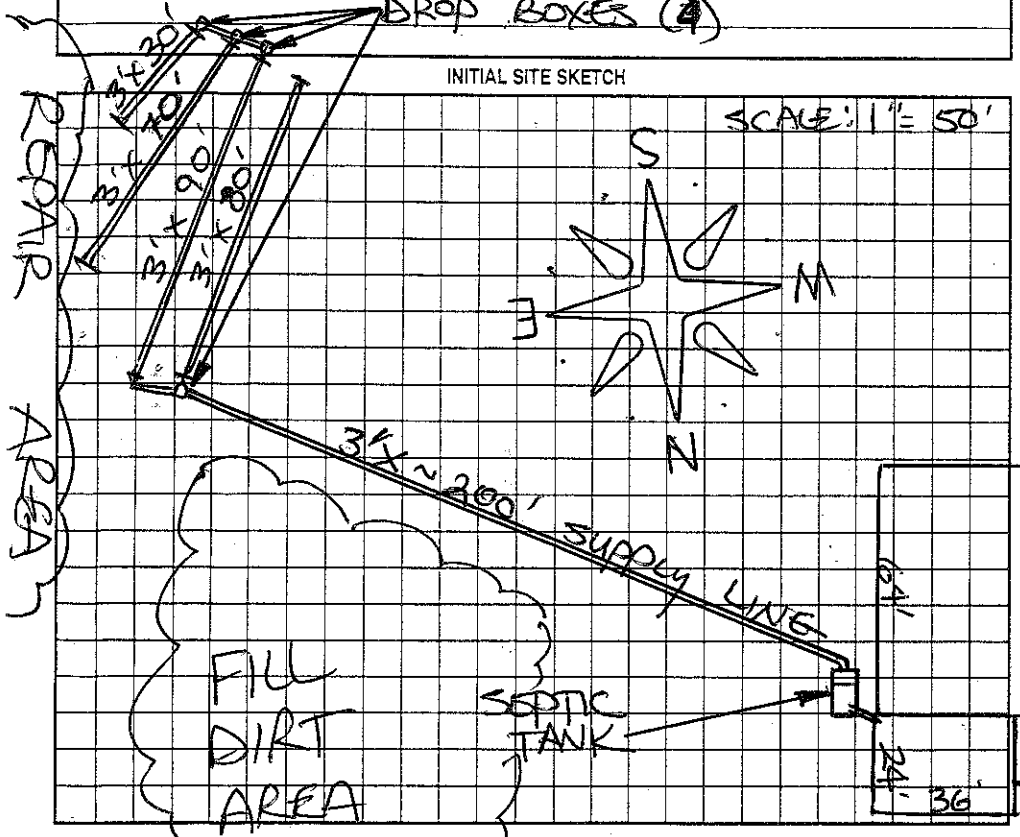


AS BUILT SKETCH

Permit can be suspended or revoked if any false information is supplied toward securing the permit/any unauthorized changes are made to the site/any unauthorized changes are made in the installation of the system. Improvement Permit with plat valid without expiration. Improvement Permit with site plan valid for sixty months. Authorization to Construct is valid for a period equal to that of Improvement Permit – not to exceed sixty months.

Signed: Michael Corum date 6/26/2003 Installed by: A-1 Backhoe

Improvement Permit by: STEVE HEDRICK date 6-26-03 Operation Permit by: Christopher M. Shemwell, RS date 2-25-04

Authorization to Construct by: STEVE HEDRICK date 6-26-03 Existing System Inspection by: ____ date ____

HEALTH DEPT. COPY: WHITE OWNER COPY (FINAL): YELLOW OWNER COPY (INITIAL): PINK