IREDELL COUNTY HEALTH DEPARTMENT

Const. Auth. STATESVILLE 704-878-5305 MOORESVILLE 704-664-5281

IMPROVEMENT PERMIT / ~~CERTIFICATE OF COMPLETION~~ / OPERATION PERMIT / EXISTING SYSTEM INSPECTION

PROPERTY DESCRIPTION NO. 069127 DATE Oct. 6, '97 TAX MAP NO. 4801 98 3518 Watershed: ☑ Yes ☐ No

OWNER OR CONTRACTOR Wayne Benfield PHONE: Business _____ Home _____ WSII PA

ADDRESS 1224 33rd St NE Conover 28613

LOCATION 115 N. TR Mtn. View TR Love Valley TR Fox Mtn. on left before 1st by Bacon Rd.

SUBDIVISION W. Benfield Prop. BLOCK / SECTION _____ LOT 3 LOT AREA .68ac SITE CLASS. AS DESIGN FLOW 600gpd L.T.A.R. .w.3

Septic Tank: 1000 Gallons; STB 1007 Date 10-6-97

Pump Tank: _____ Gallons; PT _____ Date _____

Pump Make: _____ Model _____ Serial No. _____

Nitrification Field: No Fields 1 Square Feet 810 Linear Feet 270

No Lines 4@67.5' Trench Width 36" Max Trench Bottom Depth 24"

☑ New System ☐ Repair System Type: I, II, III, IV, V, VI

System Description: Gravity Conventional

Repair System Description: Same

Maintenance Agreement Required: ☐ Yes ☑ No

Gravel Depth 12" ☐ Slab ☑ Crawl Space ☐ Basement w/plumbing ☐ Basement wo/plumbing

☑ House/Mod. Home No. Bedrooms 2

☐ Mobile Home No. Bathrooms 1

☐ Business No. Employees ____

☐ Other _____


Water Supply: ☑ Individual ☐ Community ☐ Public

Comments:


Comments:

1"=50'

INITIAL SITE SKETCH

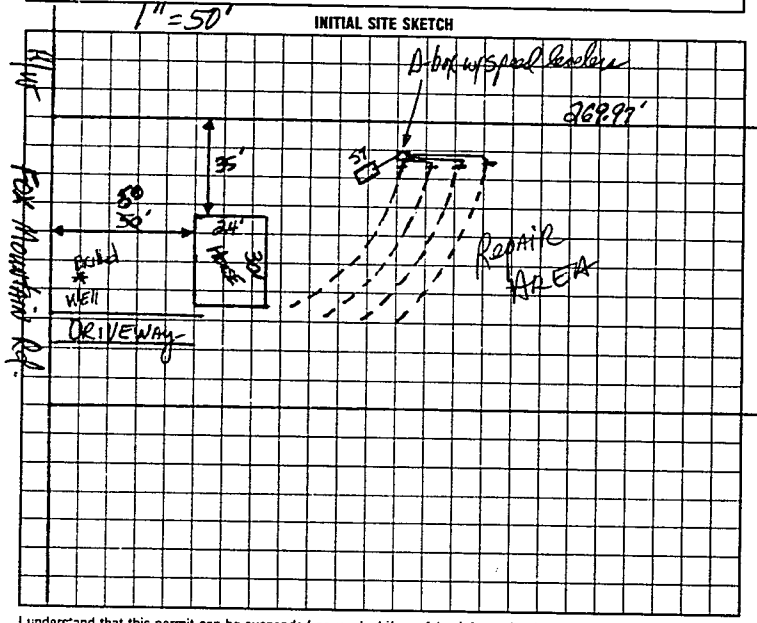

AS BUILT SKETCH

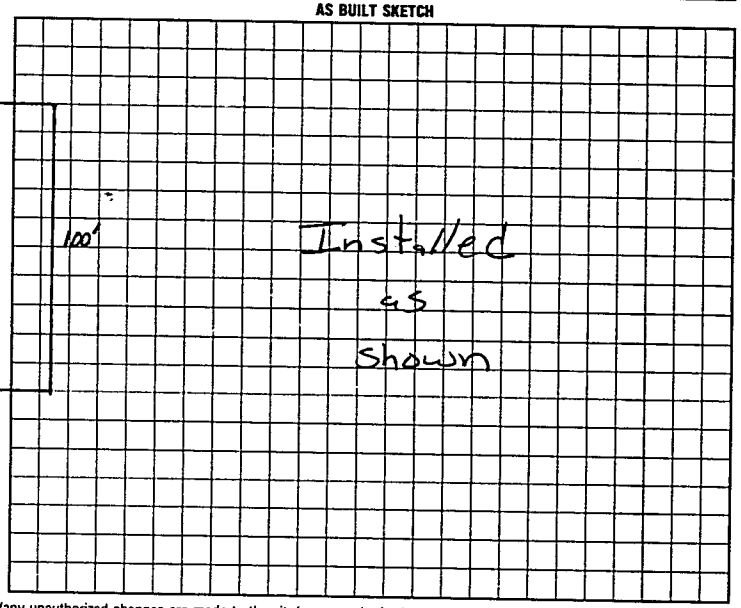

I understand that this permit can be suspended or revoked if any false information is supplied toward securing the permit/any unauthorized changes are made to the site/any unauthorized changes are made in the installation of the system. Improvement Permit is valid for 60 months from date of issuance.

Signed: _____

Improvement Permit by: D. Hamrick RS date 10-6-97

~~Construction~~ Authorization by: D. Hamrick RS date 10-6-97

Installed by: Ron Dishman

Certificate of Completion by: _____ date _____

Operation Permit by: Mark C. Ozier RS date 11-6-97

HEALTH DEPT COPY WHITE INSPECTION COPY (FINAL) GREEN OWNER COPY (FINAL) YELLOW INSPECTION COPY (INITIAL) PINK OWNER COPY (INITIAL) GOLD

1,60800