IREDELL COUNTY HEALTH DEPARTMENT Const. Auth. STATESVILLE 704-878-5305 MOORESVILLE 704-664-5281

IMPROVEMENT PERMIT / ~~CERTIFICATE OF COMPLETION~~ / OPERATION PERMIT / EXISTING SYSTEM INSPECTION

PROPERTY DESCRIPTION NO. 069129 DATE Oct. 6, '97 TAX MAP NO. 4801 98 3518 Watershed: ☑ Yes ☐ No

OWNER OR CONTRACTOR Wayne Benfield PHONE: Business 256-5068 Home WSIIPA

ADDRESS 1224 33rd St. NE Conover 28613

LOCATION 115 N. TL Mtn. View TR Love Valley TL Fox Mtn on left before Bacon Rd.

SUBDIVISION W. Benfield prop. BLOCK / SECTION LOT 5 LOT AREA .68Ac SITE CLASS. PS DESIGN FLOW 240 gpd L.T.A.R. ~.3

Septic Tank: 1000 Gallons; STB 774 Date 10-22-00

Pump Tank: Gallons; PT Date

Pump Make: Model Serial No.

Nitrification Field: No. Fields 1 Square Feet 810 Linear Feet 270

No. Lines 2 @ 135' Trench Width 36" Max Trench Bottom Depth 24" Gravel Depth 12"

☑ New System ☐ Repair System Type: I, II, III, IV, V, VI

System Description: Gravity conventional

Repair System Description: Same

Maintenance Agreement Required: ☐ Yes ☑ No

☑ House/Mod. Home No. Bedrooms 2

☐ Mobile Home No. Bathrooms 1

☐ Business No. Employees

☐ Other

☐ Slab ☑ Crawl Space ☐ Basement w/plumbing ☐ Basement wo/plumbing


Water Supply: ☑ Individual ☐ Community ☐ Public

Comments: Remove old Farm Barns


Comments: ① INSTALLED USING TUFF TITE FILTER ② Distribution BOX SET WITH SPEED LEVELERS ③ INSTALLED WITH MARKER

1" = 50'

INITIAL SITE SKETCH

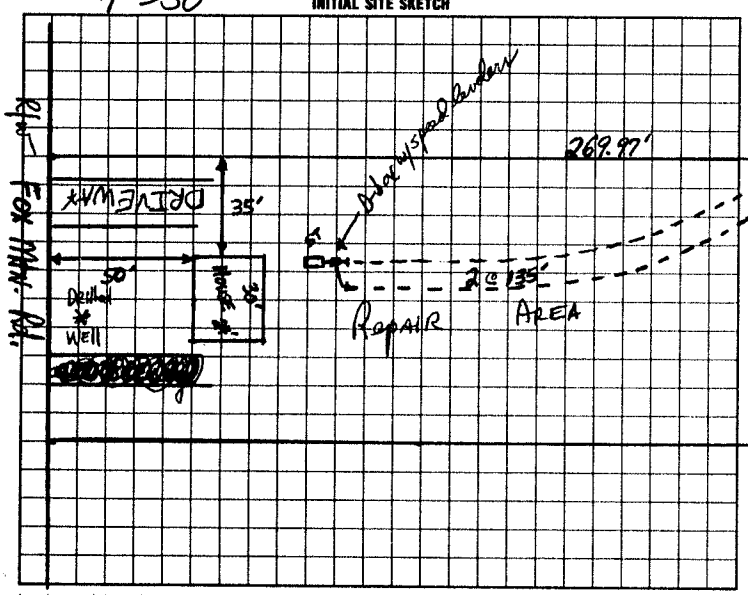

AS BUILT SKETCH

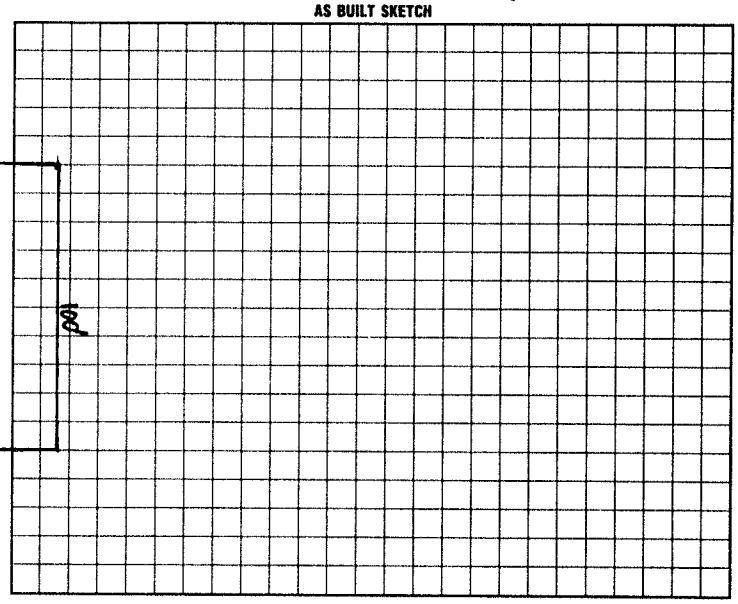

I understand that this permit can be suspended or revoked if any false information is supplied toward securing the permit/any unauthorized changes are made to the site/any unauthorized changes are made in the installation of the system. Improvement Permit is valid for 60 months from date of issuance.

Signed: Wayne Benfield

Improvement Permit by: [signature] RS date 10-6-97

~~Existing System Inspection~~ CONSTRUCTION Authorization by: [signature] RS date 10-6-97

Installed by: ANDY MANIELS

Certificate of Completion by: Steve Cook RSI date 01-11-01

Operation Permit by: date

HEALTH DEPT. COPY: WHITE INSPECTION COPY (FINAL): GREEN OWNER COPY (FINAL): YELLOW INSPECTION COPY (INITIAL): PINK OWNER COPY (INITIAL): GOLD