IREDELL COUNTY HEALTH DEPARTMENT

STATESVILLE 704-878-5305 MOORESVILLE 704-664-5281

IMPROVEMENT PERMIT / AUTHORIZATION TO CONSTRUCT / OPERATION PERMIT / EXISTING SYSTEM INSPECTION

PERMIT# R5713 PIN# 4801984738 DATE Jan 10, 2005

OWNER OR CONTRACTOR Jerald Martin PHONE: Business 336-830-3025 Home

ADDRESS 400 Delia Road Mocksville N.C. 27028

LOCATION 115 N TL Mountainview TR @ Love Valley sign TL Fox Mtn Rd on left ~250' before int w/ Bacon Rd

SUBDIVISION Wayne Bunfield BLOCK / SECTION LOT 6 LOT AREA 180 X 300' (Road Cir) SITE CLASS. PS DESIGN FLOW 240gpd L.T.A.R. .3

Septic Tank: 1000 Gallons; STB 760 Date 9-22-05

Pump Tank: Gallons; PT Date

Pump Make: Model Serial No.

Nitrification Field: No Fields 1 Square Feet 800 Linear Feet 267

No Lines 4 Trench Width 36" Max Trench Bottom Depth 36" Gravel Depth 12"

☑ New System ☐ Repair System Type: I, II, III, IV, V, VI

System Description: Gravity conventional

Repair System Description: Gear 75% Reduction

Maintenance Agreement Required: ☐ Yes ☑ No

☑ House/Mod. Home No. Bedrooms 2

☐ Mobile Home No. Bathrooms

☐ Business No. Employees

☐ Other


☐ Slab ☑ Crawl Space ☐ Basement w/plumbing ☐ Basement wo/plumbing

Water Supply: ☑ Individual ☐ Public ☐ Community


Comments:/Conditions:

Comments:/Conditions: POLYLOK FILTER + MARKER. INSTALLED AS DRAWN. WELL IS 67' TO TANK

INITIAL SITE SKETCH 1"=50'

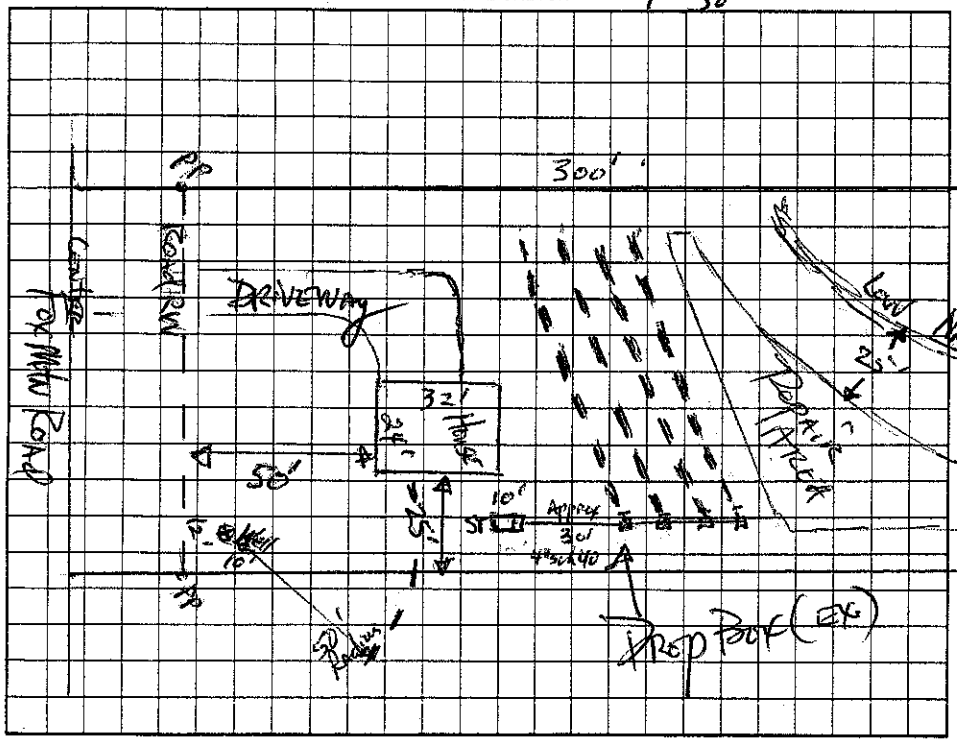

AS BUILT SKETCH

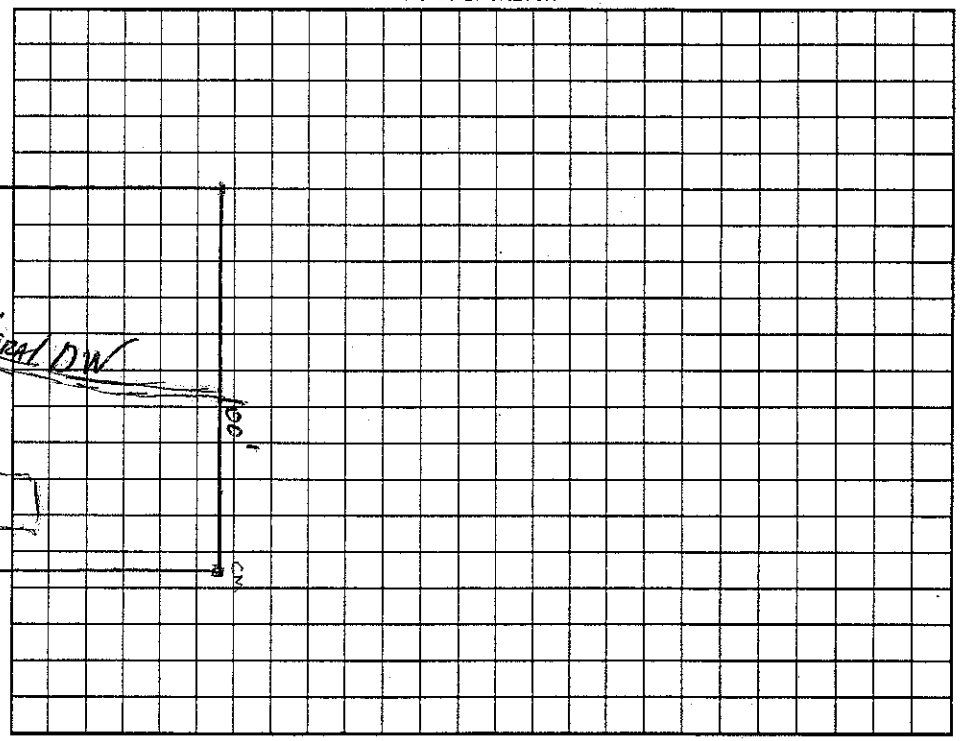

Permit can be suspended or revoked if any false information is supplied toward securing the permit/any unauthorized changes are made to the site/any unauthorized changes are made in the installation of the system. Improvement Permit with plat valid without expiration. Improvement Permit with site plan valid for sixty months. Authorization to Construct is valid for a period equal to that of Improvement Permit – not to exceed sixty months.

Signed: Jerald L Martin date 1-10-05 Installed by: DUNN GRADING

Improvement Permit by: RS date Jan 10, 05 Operation Permit by: date 3-30-05

Authorization to Construct by: RS date Jan 10, 05 Existing System Inspection by: date

HEALTH DEPT. COPY: WHITE OWNER COPY (FINAL): YELLOW OWNER COPY (INITIAL): PINK