IREDELL COUNTY HEALTH DEPARTMENT

STATESVILLE 704-878-5305 MOORESVILLE 704-664-5281

IMPROVEMENT PERMIT / CERTIFICATE OF COMPLETION / OPERATION PERMIT / EXISTING SYSTEM INSPECTION

PROPERTY DESCRIPTION NO. 69131 DATE Oct. 6, 97 TAX MAP NO. 4801 98 3518 Watershed: ☑ Yes ☐ No

OWNER OR CONTRACTOR Wayne Benfield PHONE: Business _____ Home _____ WSTR PA

ADDRESS 1224 33rd St NW Conover 28613

LOCATION 115 N. to Mtn. View TR Long Valley TR Fox Mtn. on left before Bacon Rd.

SUBDIVISION W. Benfield prop. BLOCK / SECTION _____ LOT 7 LOT AREA .6 Ac SITE CLASS. RS DESIGN FLOW 240 gpd L.T.A.R. ~.3

Septic Tank: 1000 Gallons; STB 825 Date 3-4-00

Pump Tank: _____ Gallons; PT _____ Date _____

Pump Make: _____ Model _____ Serial No. _____

Nitrification Field: No Fields 1 Square Feet 810 Linear Feet 270

No Lines 4 @ 67.5' Trench Width 36" Max Trench Bottom Depth 24"

☑ New System ☐ Repair System Type: I, II, III, IV, V, VI

System Description: gravity conventional

Repair System Description: same

Maintenance Agreement Required: ☐ Yes ☑ No

Gravel Depth 12"

☑ House/Mod. Home ☐ Mobile Home ☐ Business ☐ Other

No. Bedrooms 2 No. Bathrooms 1 No. Employees _____

☐ Slab ☑ Crawl Space ☐ Basement w/plumbing ☐ Basement wo/plumbing


Water Supply: ☑ Individual ☐ Community ☐ Public

Comments:

Comments:

1"=50'

INITIAL SITE SKETCH

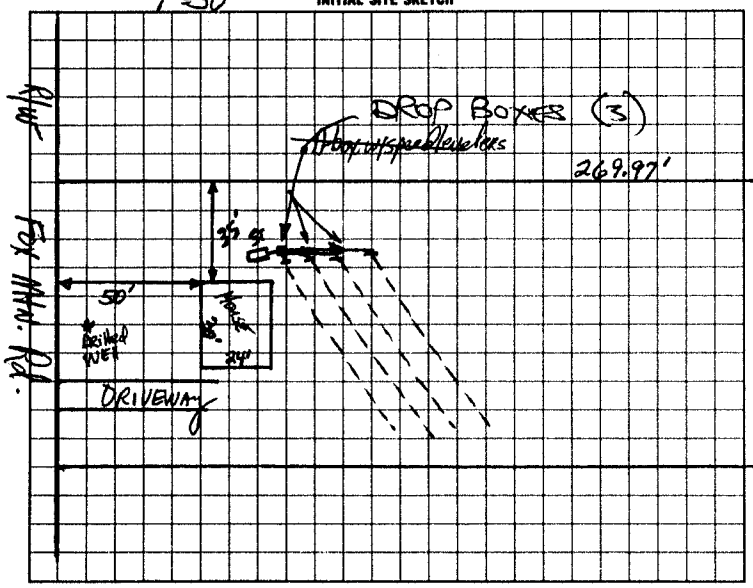

AS BUILT SKETCH

SYSTEM INSTALLED ACCORDING TO INITIAL SITE SKETCH

I understand that this permit can be suspended or revoked if any false information is supplied toward securing the permit/any unauthorized changes are made to the site/any unauthorized changes are made in the installation of the system. Improvement Permit is valid for 60 months from date of issuance.

Signed: Wayne Benfield

Improvement Permit by: _____ date 10-6-97

Construction ~~Authorization~~ by: _____ date 10-6-97

Installed by: ANDY DANIELS

Certificate of Completion by: STEVE HENDRICK date 4-19-00

Operation Permit by: _____ date _____

HEALTH DEPT. COPY: WHITE INSPECTION COPY (FINAL): GREEN OWNER COPY (FINAL): YELLOW INSPECTION COPY (INITIAL): PINK OWNER COPY (INITIAL): GOLD