IREDELL COUNTY HEALTH DEPARTMENT

Statesville Office (704) 878-5305 Mooresville Office (704) 660-3625 PERMIT # 179930

IMPROVEMENT PERMIT / AUTHORIZATION TO CONSTRUCT / OPERATION PERMIT / EXISTING SYSTEM

PIN # 4802-709-821

APPLICANT: ROY LEE HESTER APPLICANT ADDRESS: 136 PENNY DRIVE

SITE ADDRESS: 136 PENNY DRIVE, STATESVILLE PHONE: 704-592-2138 ALT. PHONE:


SITE DIRECTIONS: 115 N, (L) MOUNTAIN VIEW (R) BACON RD (L) PENNY DR, PROPERTY ON (R)

SUBDIVISION: SECTION: LOT # LOT AREA: 0.68 AC DESIGN FLOW: 240 GPD L.T.A.R.: 0.25 GPD/FT²


Septic Tank	1000 (gal)	STB 760-1060	Date 5-13	☐ New System ☒ Repair ☐ Expansion	System Type: I II (III) IV V VI	☒ Residence	No. Bedrooms 2	Water Supply
Pump Tank	1000 (gal)	PT 363-1000	Date 2-25-13	System Description:		☐ Business	No. Persons	☒ Private
Pump Make	Goulds	Model PJN R1003260	Serial # 26PM8DV08	Repair System Description: PUMP TO 25% REDUCTION		☐ Other	No. Employees	☐ Public
# Nitrification Fields	1	# Lines 4	Linear Ft: 240	Maintenance Agreement Required:	☐ YES ☒ NO	☐ Slab	☒ Crawl Space	☐ Community
Trench Width	36"	Max. Trench Bottom Depth 36"	Gravel Depth N/A		☐ GRAVITY ☒ PRESSURE	☐ Basement w/plumbing		☐ Basement w/o plumbing

Comments / Conditions: INSTALL 25% REDUCTION SYSTEM ON CONTOUR AS SHOWN USING EQUAL DISTRIBUTION. SEE ATTACHED SHEETS FOR PUMP AND PRESSURE MANIFOLD REQUIREMENTS. MAINTAIN ALL SETBACKS

INITIAL SITE SKETCH

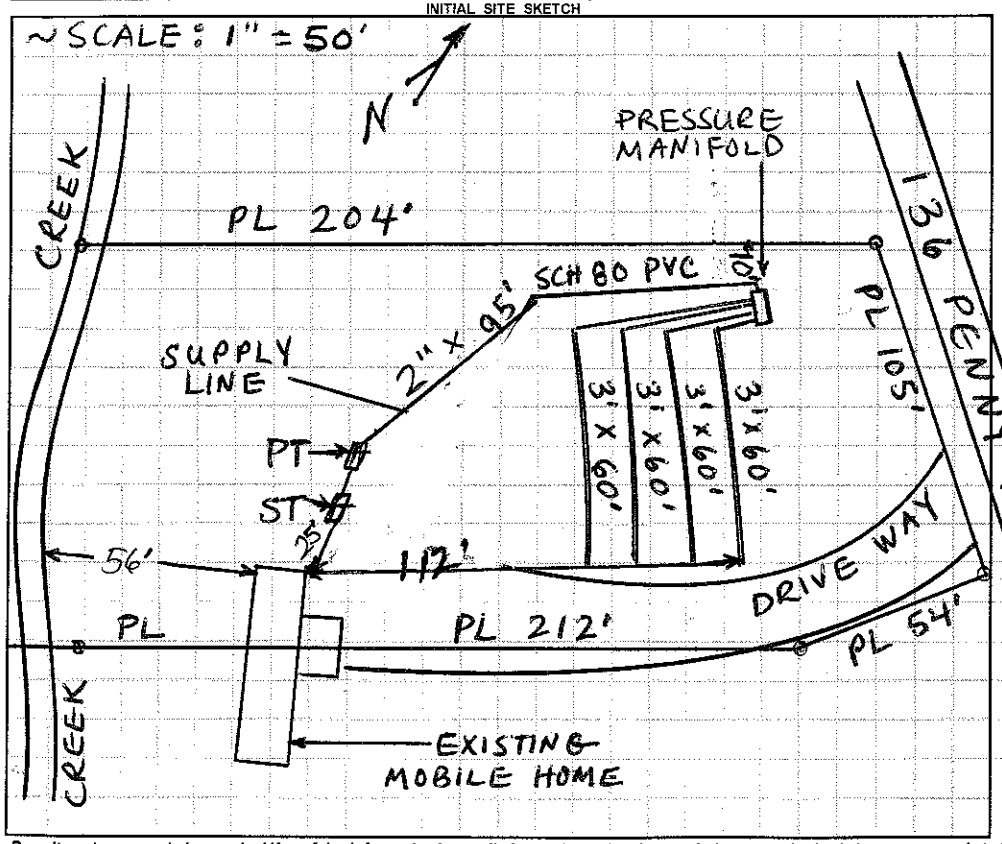

AS BUILT SKETCH

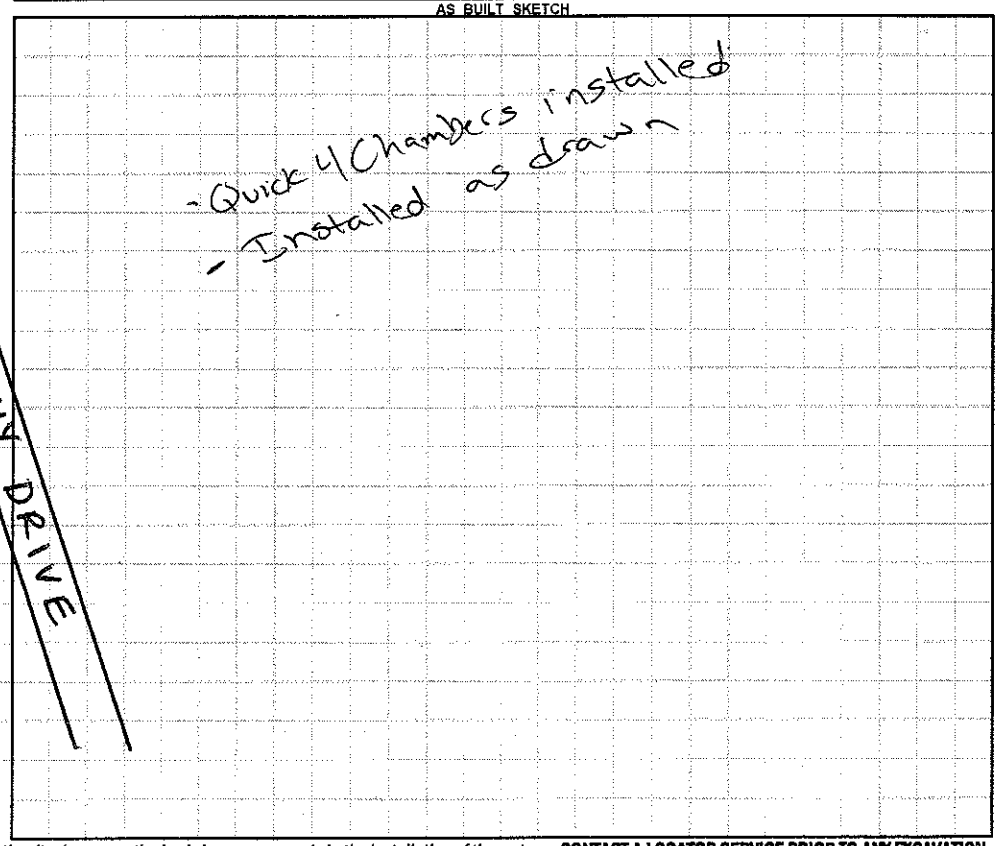

Permit can be suspended or revoked if any false information is supplied toward securing the permit / any unauthorized changes are made to the site / any unauthorized changes are made in the installation of the system. **CONTACT A LOCATOR SERVICE PRIOR TO ANY EXCAVATION**

☐ **IMPROVEMENT PERMIT** *with plat valid without expiration.* ☒ **IMPROVEMENT PERMIT** *with site plan valid for 60 mos.* ☒ **AUTHORIZATION TO CONSTRUCT** *valid for period equal to IMPROVEMENT PERMIT--not to exceed 60 mo.*

Owner / Applicant Signature: Roy Lee Hester Date: 8/29/13 Installed by: A1 Backhoe

IMPROVEMENT PERMIT by: Kimberley Mearns, REHS Date: 8/29/13 OPERATION PERMIT by: Justin Henderson Date: 10-3-13

AUTHORIZATION TO CONSTRUCT by: Kimberley Mearns, REHS Date: 8/29/13 Existing System Inspected by: Date:

Health Dept. Copy - WHITE Applicant (Final Approval) - YELLOW Applicant (Conditional Approval) - PINK