IREDELL COUNTY HEALTH DEPARTMENT

Statesville Office (704) 878-5305 Mooresville Office (704) 660-3625 PERMIT # 214930

IMPROVEMENT PERMIT / AUTHORIZATION TO CONSTRUCT / OPERATION PERMIT / EXISTING SYSTEM

PIN # 4802-72-5527

APPLICANT: Americas Home Place APPLICANT ADDRESS: 1206 Greenland Drive

SITE ADDRESS: 300 Mason Farm Rd Statesville, NC 28625 PHONE: 704-881-1023 ALT. PHONE:

SITE DIRECTIONS: Rt 115 N → L on Mountain View Rd → R on Bacon Rd → L on Mason Farm Rd → Lot on Right (partially in Alexander County)

SUBDIVISION: — SECTION: — LOT # — LOT AREA: 25.7 acres DESIGN FLOW: 360 GPD L.T.A.R.: 0.30


Septic Tank	1000	(gal)	STB	160	Date	12-31-1	☒ New System	☐ Repair	☐ Expansion	System Type: I II (III) IV V VI	
Pump Tank	—	(gal)	PT	—	Date	—	System Description:	25% Reduction			
Pump Make	—		Model	—	Serial #	—	Repair System Description:	25% Reduction			
# Nitrification Fields	1		# Lines	4	Linear Ft:	300	Maintenance Agreement Required:	☐ YES	☒ NO		
Trench Width	36"		Trench Bottom Depth	28" (Low side)	Gravel Depth	—		☒ GRAVITY	☐ PRESSURE		

☒ Residence	No. Bedrooms	3	Water Supply
☐ Business	No. Persons	6	☐ Private
☐ Other	No. Employees		☐ Public
☐ Slab	☒ Crawl Space		☐ Community
☐ Basement w/plumbing			☐ Basement w/o plumbing

Comments / Conditions: Recommend pumping septic tank every 3-5 years

Red filter
Installed Infiltrator Quick 4 as drawn

INITIAL SITE SKETCH

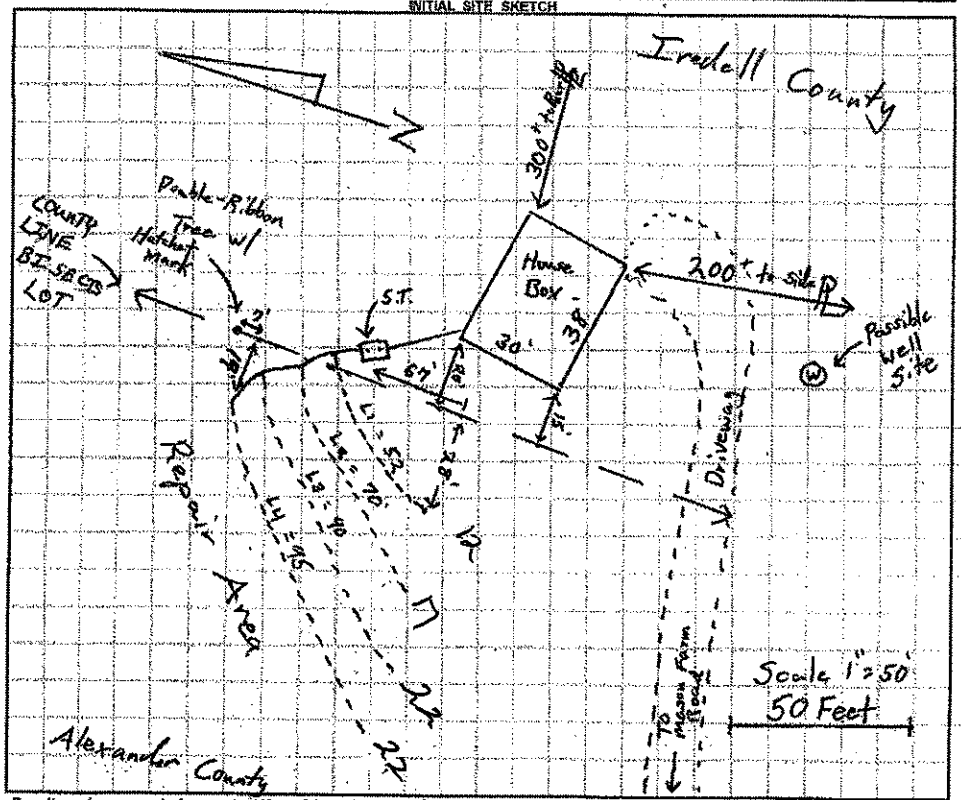

AS BUILT SKETCH

House not built at time of inspection

Permit can be suspended or revoked if any false information is supplied toward securing the permit / any unauthorized changes are made to the site / any unauthorized changes are made in the installation of the system. **CONTACT A LOCATOR SERVICE PRIOR TO ANY EXCAVATION**

☐ **IMPROVEMENT PERMIT** *with plat valid without expiration.* ☒ **IMPROVEMENT PERMIT** *with site plan valid for 60 mos.* ☒ **AUTHORIZATION TO CONSTRUCT** *valid for period equal to IMPROVEMENT PERMIT--not to exceed 60 mo.*

Owner / Applicant Signature: Date: 3/31/17 Installed by: Groundbreakers

IMPROVEMENT PERMIT by: Sam Shuck Date: 3/23/17 OPERATION PERMIT by: Maria Dotson Date: 4/19/17

AUTHORIZATION TO CONSTRUCT by: Sam Shuck Date: 3/27/17 Existing System Inspected by: Date:

Health Dept. Copy - WHITE Applicant (Final Approval) - YELLOW Applicant (Conditional Approval) - PINK