IREDELL COUNTY HEALTH DEPARTMENT

Statesville Phone TR 3-7271 Mooresville Phone NO 3-1271

PERMIT TO INSTALL SEPTIC TANK

Permit No. _____ Permit Date Dec 29-30 19 71

Owner Douglas Hicks Address Fay Mountain

Installed By Harlie Lackey Address Stony Point.


Location of Property North out 115 about Central School. go by Taylorsprings Church. To Mabbery Store & ask there. Back Side Fay mountain, North.

Tank		Capacity		Length of Lines		Fixtures	
Block	( )	1000	( )	225'	( )	No. of Baths	( )
Precast	(✓)	1250	( )	250'	( )	Dishwasher	( )
		1500	( )	Other 70 Ft		Garbage Grdr.	( )
		Other _____				Other _____	

NOTIFY HEALTH DEPARTMENT AT LEAST EIGHT HOURS BEFORE TANK IS TO BE INSPECTED.

Final Inspection _____ 19___ Approved ( ) Disapproved ( )

Remarks Had to build fill for Drain field & Tank

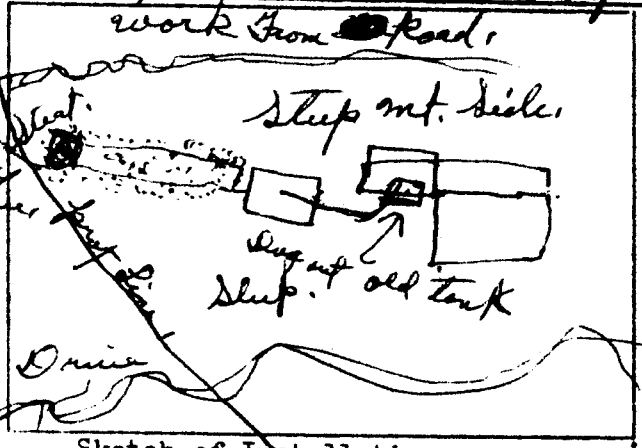

Sketch of Installation

2 Lines 5 Ft wid 18" Stone 40 ft long pit at end 24 tons Stone.

Glen Ft asisted on this Job.

_____

Sanitarian