IREDELL COUNTY HEALTH DEPARTMENT

STATESVILLE 704-878-5305 MOORESVILLE 704-664-5281

IMPROVEMENT PERMIT / CERTIFICATE OF COMPLETION / OPERATION PERMIT / EXISTING SYSTEM INSPECTION

PROPERTY DESCRIPTION NO. 16256 DATE 4-30-96 TAX MAP NO. 15DA180 Watershed: ☐ Yes ☒ No ?

OWNER OR CONTRACTOR Harold S. Wiggins PHONE: Business Home 664-9127

ADDRESS

LOCATION 115N TL Mtn View Rd TR Bacon Rd TL Fox Mtn Rd on Left top of Hill

SUBDIVISION BLOCK / SECTION LOT LOT AREA 2.49 ac. SITE CLASS. P/S DESIGN FLOW 340 L.T.A.R. 0.35

Septic Tank: 1000 Gallons; STB 1012 Date 9-23-96

Pump Tank: Gallons; PT Date

Pump Make: Model Serial No.

Nitrification Field: No Fields 1 Square Feet 670 Linear Feet 280

No Lines 7 Trench Width 36 Max Trench Bottom Depth 36 Gravel Depth 12

☒ New System ☐ Repair System Type: I, II, III, IV, V, VI

System Description: Gravity Conventional

Repair System Description: Gravity Conventional

Maintenance Agreement Required: ☐ Yes ☐ No

☐ Slab ☐ Crawl Space ☐ Basement w/plumbing ☐ Basement wo/plumbing

☒ House/Mod. Home No. Bedrooms 2

☐ Mobile Home No. Bathrooms 1

☐ Business No. Employees

☐ Other


Water Supply: ☒ Individual ☐ Community ☐ Public

Comments:

Comments: Keep well 50ft from system

INITIAL SITE SKETCH

AS BUILT SKETCH

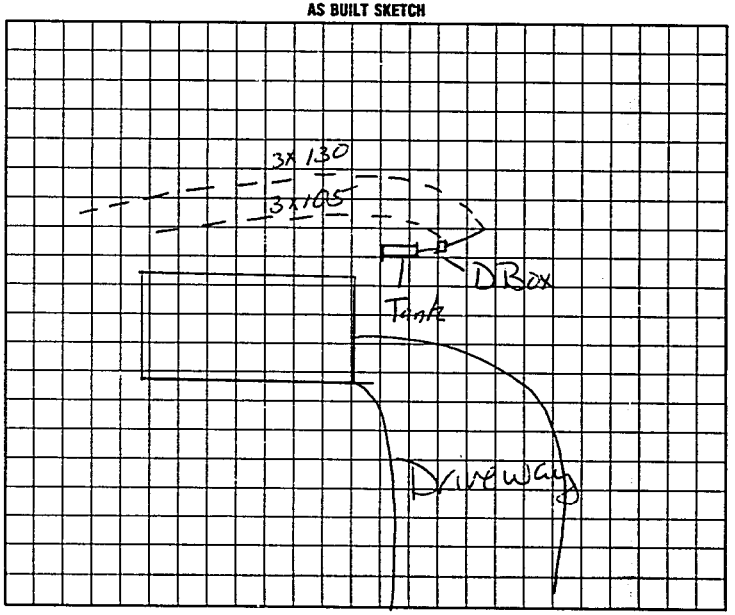

I understand that this permit can be suspended or revoked if any false information is supplied toward securing the permit/any unauthorized changes are made to the site/any unauthorized changes are made in the installation of the system. Improvement Permit is valid for 60 months from date of issuance.

Signed:

Improvement Permit by: date

Existing System Inspection by: date

Installed by: A-1 Backhoe

Certificate of Completion by: date

Operation Permit by: J. Mark C. Offs date 12-16-96

HEALTH DEPT. COPY: WHITE INSPECTION COPY (FINAL): GREEN OWNER COPY (FINAL): YELLOW INSPECTION COPY (INITIAL): PINK OWNER COPY (INITIAL): GOLD

00279