IREDELL COUNTY HEALTH DEPARTMENT

049561

STATESVILLE 704-878-5305 MOORESVILLE 704-664-5281

IMPROVEMENT PERMIT / CERTIFICATE OF COMPLETION / OPERATION PERMIT / EXISTING SYSTEM INSPECTION

PROPERTY DESCRIPTION NO. 26197 // 26198 DATE 8-12-97 TAX MAP NO. 4802-85-1729 Watershed: ☐ Yes ☑ No

OWNER OR CONTRACTOR R.S. HOLLIFIELD PHONE: Business Home 871-1175

ADDRESS P.O. Box 1036, TROUTMAN, NC 28166

LOCATION NC 115 N, TL COOLBROOK, TL FOX MOUNTAIN RD, 0.9 MILE ON RIGHT

SUBDIVISION FOX LAKE BLOCK / SECTION LOT 7, 8 LOT AREA 1.611 ACRES SITE CLASS. PS DESIGN FLOW 360 L.T.A.R. 0.30 GPD/FT²

Septic Tank: 1000 Gallons; STB 1012 Date 8-19-97

Pump Tank: Gallons; PT Date

Pump Make: Model Serial No.

Nitrification Field: No Fields 1 Square Feet 1200 Linear Feet 400

No Lines FOUR Trench Width 36" Max Trench Bottom Depth 36

☑ New System ☐ Repair System Type: I, II, III, IV, V, VI

System Description: CONVENTIONAL GRAVITY

Repair System Description: CHAMBERED GRAVITY

Maintenance Agreement Required: ☐ Yes ☑ No

Gravel Depth 12"

☐ House/Mod. Home No. Bedrooms 3

☑ Mobile Home No. Bathrooms 2

☐ Business No. Employees

☑ Other pump

☐ Slab ☑ Crawl Space ☐ Basement w/plumbing ☐ Basement wo/plumbing


Water Supply: ☑ Individual ☐ Community ☐ Public WELL

Comments: KEEP SYSTEM MINIMUM 100' FROM WELL.


Comments: Repair Panels

* Note House has been shifted into repair Area

INITIAL SITE SKETCH SCALE: 1" = 60'

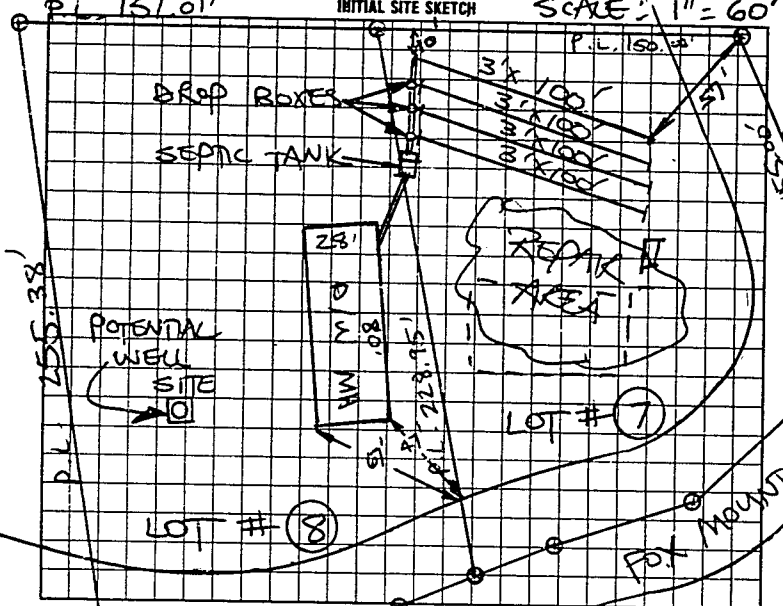

AS BUILT SKETCH

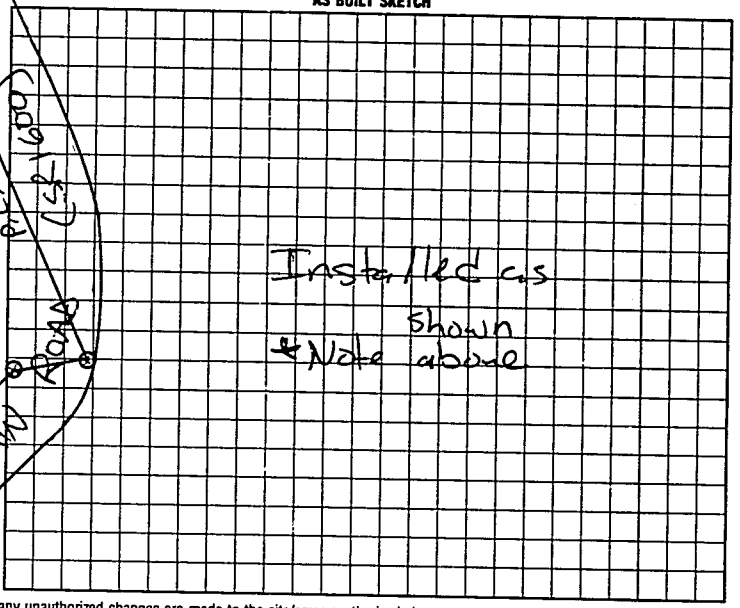

I understand that this permit can be suspended or revoked if any false information is supplied toward securing the permit/any unauthorized changes are made to the site/any unauthorized changes are made in the installation of the system. Improvement Permit is valid for 60 months from date of issuance. AUTHORIZATION TO CONSTRUCT IS VALID FOR 60 MONTHS FROM DATE OF ISSUANCE.

Signed: Tracy Rung

Improvement Permit by: STEVE HEDRICK date 8-12-97

Auth. to Const. Existing System Inspection by: STEVE HEDRICK date 8-12-97

Installed by: A-1

~~Certificate of Completion by:~~ date

Operation Permit by: Mary C. Orf 12s date 11-10-97

HEALTH DEPT. COPY: WHITE INSPECTION COPY (FINAL): GREEN OWNER COPY (FINAL): YELLOW INSPECTION COPY (INITIAL): PINK OWNER COPY (INITIAL): GOLD