THIS PERMIT VOIDS PREVIOUS ISSUED 1-11-2000

IREDELL COUNTY HEALTH DEPARTMENT

STATESVILLE 704-878-5305 MOORESVILLE 704-664-5281

IMPROVEMENT PERMIT / AUTHORIZATION TO CONSTRUCT / OPERATION PERMIT / EXISTING SYSTEM INSPECTION

PERMIT# 086729 PIN# 4802 85 9683 DATE 11-1-01

OWNER OR CONTRACTOR RONNIE PUCKETT PHONE: Business (704) 592-5437 Home ~~(704) 592-4836~~

ADDRESS 772 FOX MOUNTAIN ROAD, UNION GROVE, NC 28689

LOCATION NC 115 N, TL COOL BACK ROAD, TL FOX MOUNTAIN ROAD, 0.8 MILE ON LEFT AT CURVE, BACK OFF ROAD

SUBDIVISION HOLLIFIELD/TAYLOR BLOCK / SECTION ____ LOT 11 LOT AREA 9.00 ACRES SITE CLASS PS DESIGN FLOW 240 L.T.A.R. 0.30 GPD/FT²

Septic Tank: 1000 Gallons; STB 794 Date 9-5-01
Pump Tank: ____ Gallons; PT ____ Date ____
Pump Make: ____ Model ____ Serial No ____
Nitrification Field: No Fields 1 Square Feet EQ. to 810 Linear Feet 200+
No Lines FOUR Trench Width 36" Max Trench Bottom Depth 30" Gravel Depth N/A

☐ New System ☐ Repair System Type: I, II, (III), V, VI
System Description: 25% REDUCTION GRAVITY
Repair System Description: 25% REDUCTION GRAVITY
Maintenance Agreement Required: ☐ Yes ☐ No
☐ Slab ☑ Crawl Space ☐ Basement w/plumbing ☐ Basement wo/plumbing


☑ House/Mod. Home No. Bedrooms 1
☐ Mobile Home No. Bathrooms 1
☐ Business No. Employees ____
☐ Other ____

Water Supply: ~~☑~~ Individual ☐ Public ☐ Community
WELL

Comments/Conditions: ① INSTALL SUBSURFACE INTERCEPT DRAINAGE DITCH AT LOCATION SHOWN BEGINNING 48" DEEP. ② INSTALL 25% REDUCTION SYSTEM USING 32 CHAMBERS OR 20 HDS SECTIONS.

Comments/Conditions SEPTIC TANK WITH RISERS INSTALLED USING "POLYLOK" FILTER

INITIAL SITE SKETCH

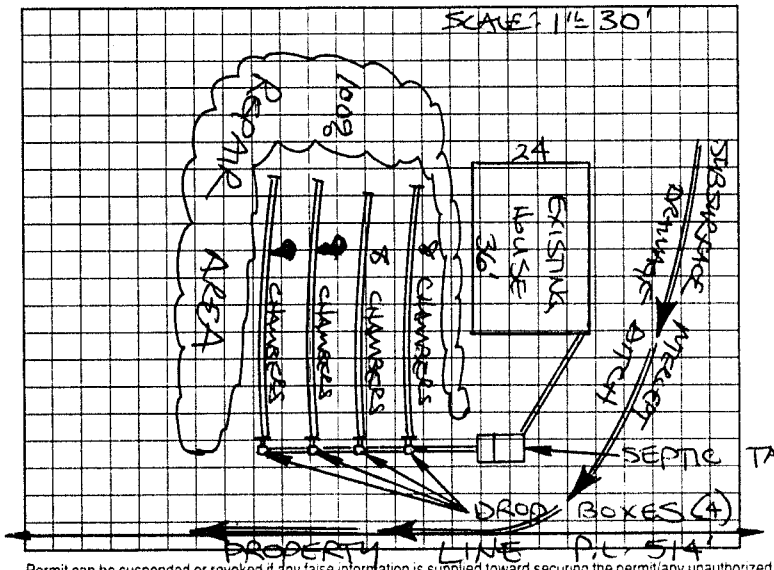

AS BUILT SKETCH

SYSTEM INSTALLED USING 20 HDS SECTIONS ACCORDING TO INITAL SITE SKETCH

Permit can be suspended or revoked if any false information is supplied toward securing the permit/any unauthorized changes are made to the site/any unauthorized changes are made in the installation of the system. Improvement Permit with plat valid without expiration. Improvement Permit with site plan valid for sixty months. Authorization to Construct is valid for a period equal to that of Improvement Permit – not to exceed sixty months.

Signed: Ronnie Puckett date ____ Installed by: STATESVILLE BACKHOE

Improvement Permit by: STEVE HEDRICK date 11-1-01 Operation Permit by: STEVE HEDRICK date 11-13-01

Authorization to Construct by: STEVE HEDRICK date 11-1-01 Existing System Inspection by: ____ date ____

HEALTH DEPT COPY WHITE OWNER COPY (FINAL) YELLOW OWNER COPY (INITIAL) PINK