IREDELL COUNTY HEALTH DEPARTMENT

STATESVILLE 704-878-5305 (a) MOORESVILLE 704-664-5281

IMPROVEMENT PERMIT / AUTHORIZATION TO CONSTRUCT / OPERATION PERMIT / EXISTING SYSTEM INSPECTION

PERMIT # 150736 PIN # 4802-92-9283 DATE 9 February 09

OWNER or APPLICANT Talmadge Kinney PHONE: Business (704)-880-2000 Home:

OWNER or APPLICANT ADDRESS 249 Ahler Rd. Stony Point, NC

LOCATION / DIRECTIONS 115N TL Mountain View - TR Bacon Rd. TL Fox Mtn. Rd. TR Sturbuck - at end on Rt

SUBDIVISION BLOCK / SECTION LOT # LOT AREA DESIGN FLOW 240 g/d L.T.A.R. 0.39 g/d/ft

Septic Tank 1000 Gallons: STB 550 Date 5-25-10

Pump Tank Gallons: P T Date

Pump Make Model Serial #

Nitrification Field No Fields 1 No Lines 4 Linear Feet 200

Trench Width 36" Max. Trench Bottom Depth 36" Gravel Depth N/A

☑ New System ☐ Repair ☐ Expansion System Type I II (III) IV V VI

System Description: 25% Reduction

Repair System Description: 50% Reduction

Maintenance Agreement Required ☐ YES ☐ NO

☑ GRAVITY ☐ PRESSURE

☑ Residence No. Bedrooms 2

☐ Business No. Persons

☐ Other No. Employees

☐ Slab ☑ Crawl Space

☐ Basement w/plumbing ☐ Basement w/o plumbing

Water Supply: ☑ Private ☐ Public ☐ Community

Comments / Conditions

Honor all setback requirements / * Keep ST 50' from well / Keep Nitrification field 100' from well /

Comments / Conditions

301-Tuc Filter & tank mark

INITIAL SITE SKETCH

* Please see Attached Site sketch.

AS BUILT SKETCH

Installed as Drawn on Site plan

Permit can be suspended or revoked if any false information is supplied toward securing the permit / any unauthorized changes are made to the site / any unauthorized changes are made in the installation of the system.

☐ *IMPROVEMENT PERMIT w / plat valid without expiration.* ☑ *IMPROVEMENT PERMIT w / site plan valid for 60 mos.* ☑ *AUTHORIZATION TO CONSTRUCT valid for period equal to IMPROVEMENT PERMIT-not to exceed 60 mo.*

Owner / Applicant Signature: X Talmadge Kinney Date 2-23-09

Improvement Permit by: R.S Date 9 Feb. 09

Authorization to Construct by: R.S. Date 9 Feb. 09

YOU SHOULD CONTACT A LOCATOR SERVICE PRIOR TO ANY EXCAVATION.


Installed by: Blackburn & Sons

Operation Permit by: R.S Date: 17 Aug. 10

Existing System Inspected by: Date:

WHITE COPY Environmental Health YELLOW COPY (Final) Owner / Applicant PINK COPY (Initial) Owner / Applicant

New Hope Township (Town of Love Valley) Irec
A Portion of Tax ID 4812-01-0957 ~ A Portion
Current owner: Love Valley Land Compa
To be conveyed to: Talmadge M. Kinney

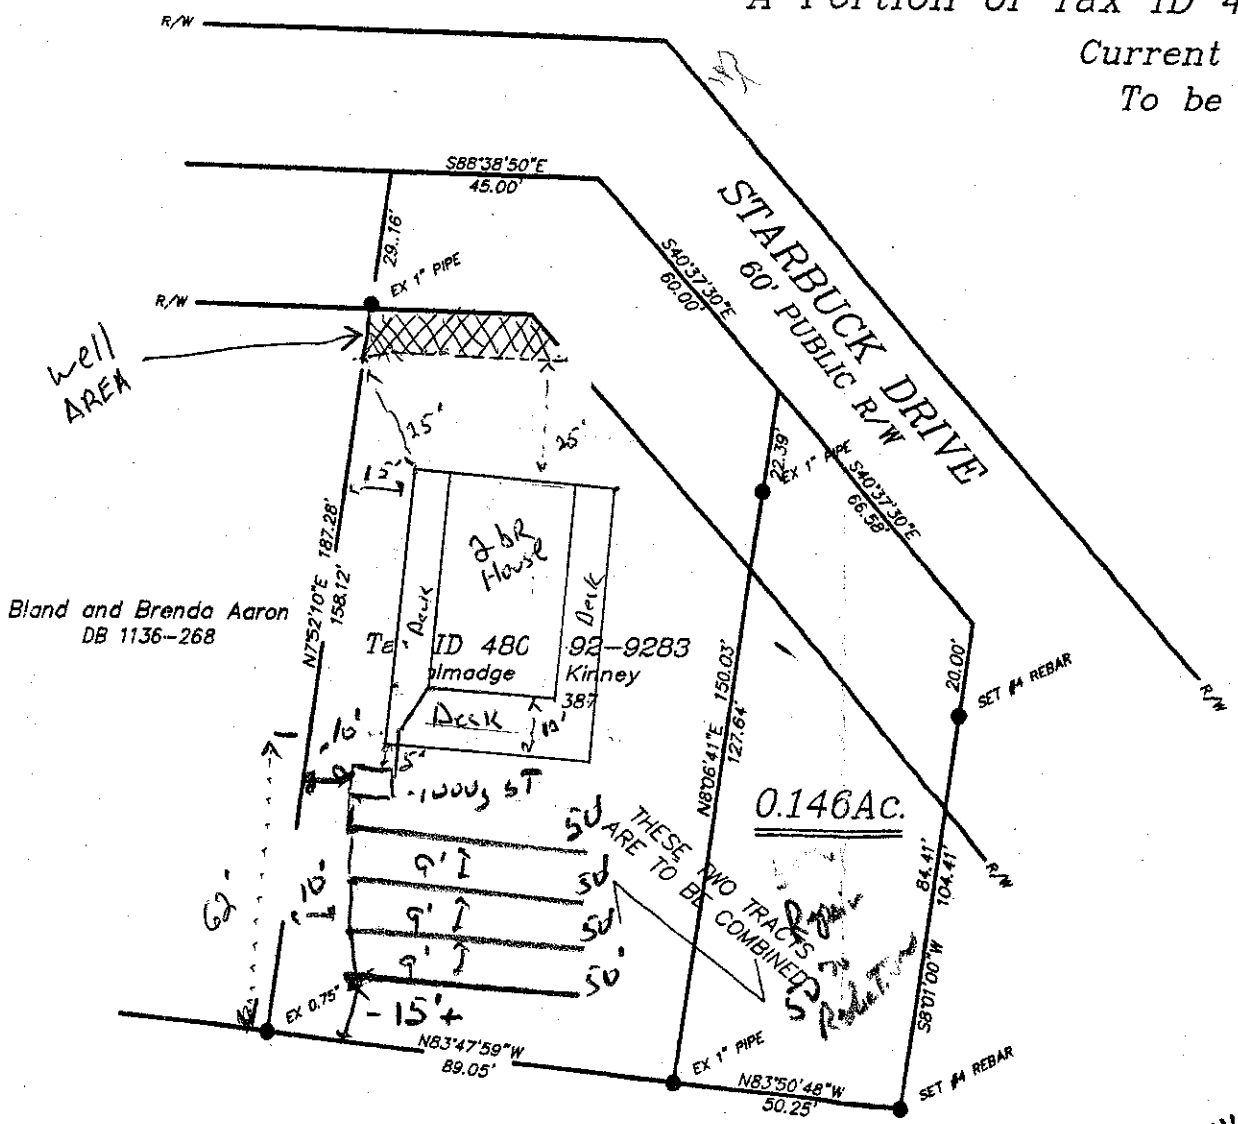

'N, ALL OTHERS CALCULATED POINTS.

ing / subdivision planning p. o. box 1036 Troutman, NC 28166
~ fax (704) 671-2777 ~ email: holiron@bellsouth.net

40 0 40 80
SCALE: 1" = 40'

NORTH CAROLINA PROFESSIONAL SEAL L-1404 LAND SURVEYOR RONALD S. HOLLIFIELD

I, Ronald S. Hollifield, certify that this plat was dra
from an actual survey made under my supervision (
in book SEE TITLE BLOCK ; map recorded in book
that the boundaries not surveyed are shown as broi
information as shown; that the ratio of precision is
recombination of existing parcels. No new parcels or
No USGS monument found within 2000'. This prope
a Special Flood Hazard Area designated by the FEA
INSURANCE RATE MAPS.

Witness my original signature, registration number, a

Ronald S. Hollifield, NCPLS 1404