48633

IREDELL COUNTY HEALTH DEPARTMENT

STATESVILLE 704-878-5305 MOORESVILLE 704-664-5281

IMPROVEMENT PERMIT / CERTIFICATE OF COMPLETION / OPERATION PERMIT / EXISTING SYSTEM INSPECTION

PROPERTY DESCRIPTION NO. 16850 DATE 8/25/93 TAX MAP NO. 15D-A-83

OWNER OR CONTRACTOR GARLAND DAVIS PHONE: Business Home 592-2426

ADDRESS Rt. 1 Box 310-D, UNION GROVE, NC 28689

LOCATION NC 115 N, TL COOLBROOK ROAD, ON (R) ~ 2.5 MILES JUST BEFORE SHARP (R) CURVE,

SUBDIVISION BLOCK / SECTION LOT LOT AREA ~7 ACRES SITE CLASS. PS L.T.A.R. 0.5 GPD/FT²

Water Supply: ☑ Individual ☐ Community ☐ Public

Septic Tank: 1000 Gallons: STB 782 Date 8/24/93

Pump Tank: Gallons: PT Date

Nitrification Field: No Fields 1 Square Feet 720 Linear Feet 240

No Lines 2 Trench Width 36" Trench Depth 18-24" Gravel Depth 12"

☑ New System ☐ Repair System Type: I, II, III, IV, V, VI

System Description: CONV. GRAVITY

Repair System Description: CONV. GRAV/PUMP

Maintenance Agreement Required: ☐ Yes ☑ No

☐ House/Mod. Home ☑ Mobile Home ☐ Business ☐ Other

No. Bedrooms 3 No. Bathrooms 2 No. Employees

Garbage Disposal: ☐ Yes ☑ No

Auto. Dishwasher: ☑ Yes ☐ No


Auto. Washing Machine: ☑ Yes ☐ No

Other

☐ Slab ☑ Crawl Space ☐ Basement w/plumbing ☐ Basement wo/plumbing

Comments (1) KEEP SYSTEM MINIMUM 5' FROM MH, 10' FROM TRAP/RM LINE, 50' FROM WELL, 50' FROM STREAMS, (2) INSTALL LINES ON CONTOUR, NO DEEPER THAN 24", 9' APART ON CENTER (3) USE SCH 80 PVC UNDER AREAS SUBJECT TO VEHICULAR TRAFFIC (4) KEEP MINIMUM 20' FROM EXISTING SYSTEM, AS BUILT SKETCH

INITIAL SITE SKETCH

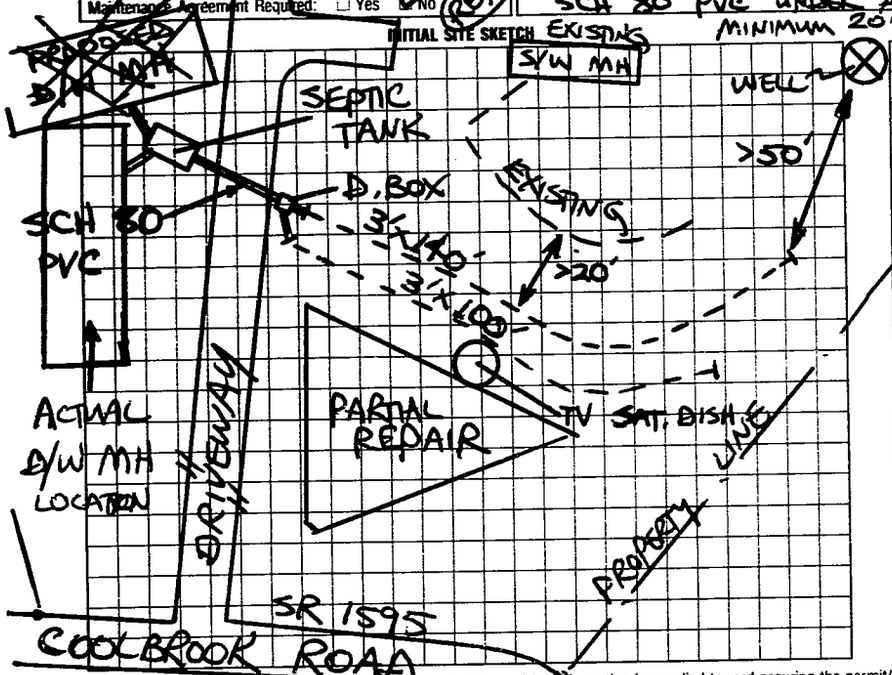

SYSTEM INSTALLED ACCORDING TO INITAL SITE SKETCH. LOCATION OF D/W MH CHANGED BUT DID NOT AFFECT SYSTEM LAYOUT.

I understand that this permit can be suspended or revoked if any false information is supplied toward securing the permit/any unauthorized changes are made to the site/any unauthorized changes are made in the installation of the system. Improvement Permit is valid for 60 months from date of issuance.

Signed X Anthony Davis

Improvement Permit by: STEVE HEDRICK date 8/25/93

Existing System Inspection by: date

Installed by: A-1 BACKHOE

Certificate of Completion by: STEVE HEDRICK date 9/24/93

Operation Permit by: date

HEALTH DEPT. COPY: WHITE INSPECTION COPY (FINAL): GREEN OWNER COPY (FINAL): YELLOW INSPECTION COPY (INITIAL): PINK OWNER COPY (INITIAL): GOLD