IREDELL COUNTY HEALTH DEPARTMENT - *ENVIRONMENTAL HEALTH* ☐ STATESVILLE OFFICE 704-878-5305 ☐ MOORESVILLE OFFICE 704-664-5281

IMPROVEMENT PERMIT / AUTHORIZATION TO CONSTRUCT / OPERATION PERMIT / EXISTING SYSTEM INSPECTION

PERMIT # 171646 PIN # 4803-44-8113 DATE APRIL 19, 2012

OWNER GREG WALKER APPLICANT: SAME PHONE: Home/Cell # 704-592-2607 Business #

SITE ADDRESS 1046 LINNEYS MILL ROAD OWNER / APPLICANT ADDRESS

SITE DIRECTIONS NC 115 N, TL LINNEYS MILL ROAD, ~3.8 MILES ON RIGHT AT BOX # 1046

SUBDIVISION BLOCK / SECTION LOT # LOT AREA 8.14 ACRES DESIGN FLOW 360 L.T.A.R. EXC 0.50 GPD

Septic Tank 1000 Gallons: STB Date

Pump Tank Gallons: P T Date

Pump Make Model Serial #

No. Nitrification Fields: 1 No. Lines 2 Linear Feet 240

Trench Width 36" Max. Trench Bottom Depth 36" Gravel Depth 12"

☐ New System ☐ Repair ☐ Expansion System Type I (II) III IV V VI

System Description: CONVENTIONAL, GRAVITY

Repair System Description: CONVENTIONAL, GRAVITY

Maintenance Agreement Required ☐ YES ☑ NO

☑ GRAVITY ☐ PRESSURE

☑ Residence No. Bedrooms 3

☐ Business No. Persons

☐ Other No. Employees

☐ Slab ☑ Crawl Space


☐ Basement w/plumbing ☐ Basement w/o plumbing

Water Supply: ☑ Private WELL ☐ Public ☐ Community


Comments / Conditions

KEEP BUILDING FOUNDATION MINIMUM 5 FEET FROM SYSTEM.

INITIAL SITE SKETCH

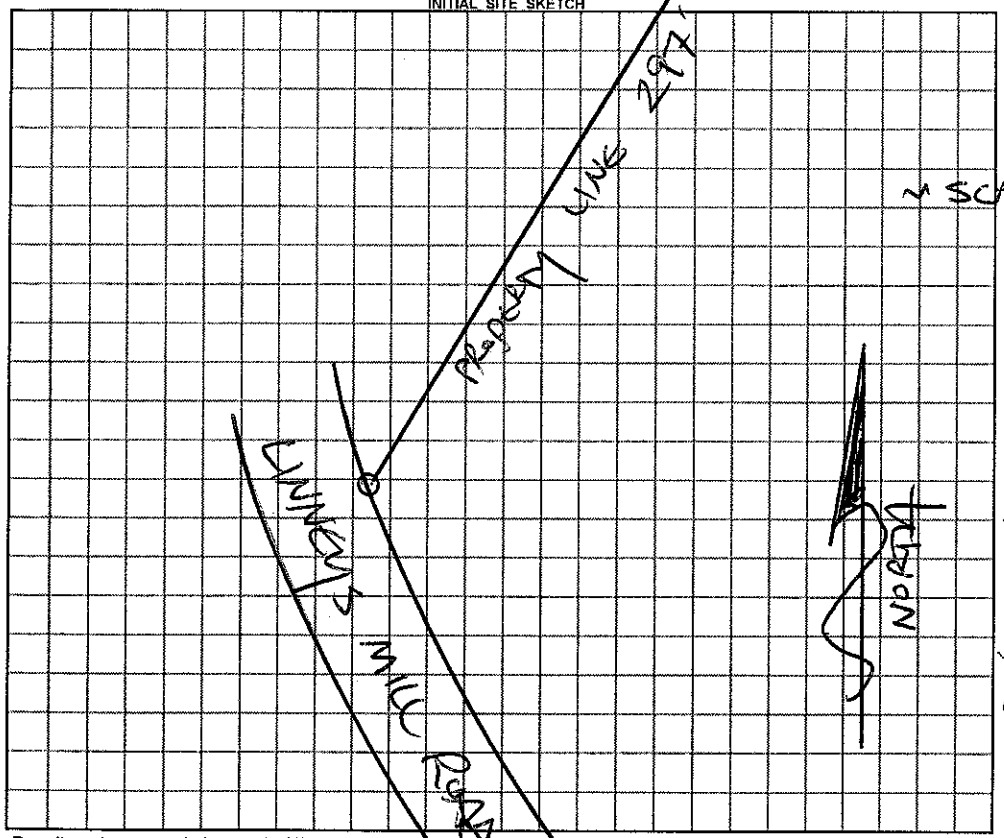

AS BUILT SKETCH

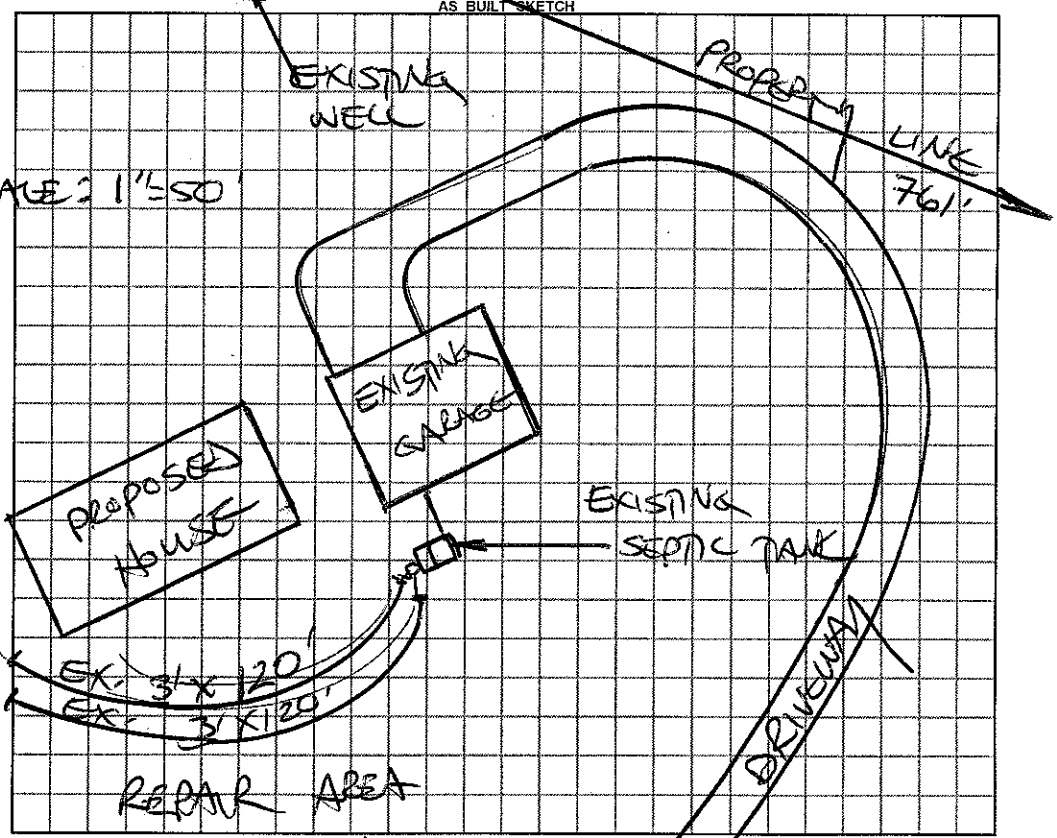

Permit can be suspended or revoked if any false information is supplied toward securing the permit / any unauthorized changes are made to the site / any unauthorized changes are made in the installation of the system.

☐ ***IMPROVEMENT PERMIT*** *with plat valid without expiration.* ☐ ***IMPROVEMENT PERMIT*** *with ~~plat valid without expiration.~~ site plan valid 60 mo.* ☐ ***AUTHORIZATION TO CONSTRUCT*** valid for period equal to IMPROVEMENT PERMIT--not to exceed 60 mo.

Owner / Applicant Signature: Date 4-19-12

IMPROVEMENT PERMIT by: REHS Date

AUTHORIZATION TO CONSTRUCT by: REHS Date

YOU SHOULD CONTACT A LOCATOR SERVICE PRIOR TO ANY EXCAVATION

Installed by:

OPERATION PERMIT by: REHS Date

Existing System Inspected by: STEVE HEDRICK REHS Date 4-19-12

White Copy -- Environmental Health YELLOW COPY (Final) Owner / Applicant PINK COPY (Initial) Owner / Applicant