IREDELL COUNTY HEALTH DEPARTMENT

STATESVILLE 704-878-5305 (1) MOORESVILLE 704-664-5281

(2) IMPROVEMENT PERMIT / AUTHORIZATION TO CONSTRUCT / OPERATION PERMIT / EXISTING SYSTEM INSPECTION

PERMIT# 109292 PIN# 4803-52-4349 DATE 10-26-02

OWNER OR CONTRACTOR LUV HOMES PHONE: Business 704-528-0848 Home

ADDRESS 1036 CHARLOTTE HWY TROUTMAN NC 28166

LOCATION NC 115 N, TL LINNEY'S MILL RD, 3.3 MILES TL BRANTON ROAD, 1ST DRIVE ON RIGHT

SUBDIVISION BLOCK / SECTION LOT LOT AREA 5.10 ACRES SITE CLASS PS DESIGN FLOW 360 L.T.A.R. 0.40 GPD/FT²

Septic Tank: 1000 Gallons: STB 760 Date 2-25-02
Pump Tank: Gallons: PT Date
Pump Make: Model Serial No
Nitrification Field: No Fields 1 Square Feet 900 Linear Feet 300
No Lines THREE Trench Width 36" Max Trench Bottom Depth 36" Gravel Depth 12"

~~New System~~ ☐ Repair System Type: I (II) III IV V VI
System Description: CONVENTIONAL GRAVITY
Repair System Description: CONVENTIONAL GRAVITY
Maintenance Agreement Required: ☐ Yes ~~No~~


~~House/Mod. Home~~ No. Bedrooms 3
☐ Mobile Home No. Bathrooms 2
☐ Business No. Employees
☐ Other
☐ Slab ~~Crawl Space~~ ☐ Basement w/plumbing ☐ Basement wo/plumbing

Water Supply: ~~Individual~~ ☐ Public ☐ Community: WELL

Comments/Conditions: KEEP SYSTEM MINIMUM 100 FEET FROM WELL

Comments/Conditions: SEPTIC TANK WITH RISERS AND MARKER INSTALLED USING "ZABEL" FILTER

INITIAL SITE SKETCH NOT TO SCALE

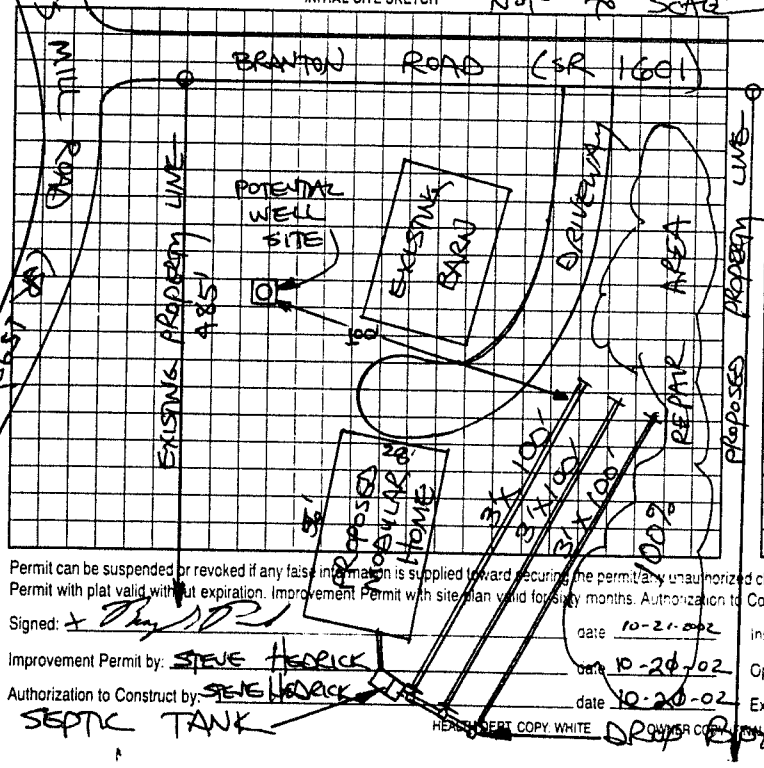

AS BUILT SKETCH

SYSTEM INSTALLED ACCORDING TO INITIAL SITE SKETCH

Permit can be suspended or revoked if any false information is supplied toward securing the permit, any unauthorized changes are made to the site any unauthorized changes are made in the installation of the system. Improvement Permit with plat valid without expiration. Improvement Permit with site plan valid for sixty months. Authorization to Construct is valid for a period equal to that of Improvement Permit – not to exceed sixty months

Signed: [signature] date 10-21-002 installed by BOB'S BACKHOE

Improvement Permit by: STEVE HENDRICK date 10-26-02 Operation Permit by: STEVE HENDRICK date 12-30-02

Authorization to Construct by: STEVE HENDRICK date 10-26-02 Existing System Inspection by: date

SEPTIC TANK DROP BOXES (3)

HEALTH DEPT COPY: WHITE OWNER COPY (FINAL): YELLOW OWNER COPY (INITIAL): PINK