3:00
3:30

IREDELL COUNTY HEALTH DEPARTMENT

STATESVILLE 704-878-5305 (W) MOORESVILLE 704-664-5281

IMPROVEMENT PERMIT / AUTHORIZATION TO CONSTRUCT / OPERATION PERMIT / EXISTING SYSTEM INSPECTION

PERMIT # 160301 PIN # 4803 56 6214 DATE April 16, 2010

OWNER or APPLICANT Jeff Styers PHONE: Business Home:

OWNER or APPLICANT ADDRESS 185 Cane Mill Cr. Union Grove

LOCATION / DIRECTIONS 115 N TL Lioneys Mill Rd TR Oak Hollow TL Hillsdale TR Cane Mill on left @ top of hill

SUBDIVISION NA BLOCK / SECTION LOT # LOT AREA 2.0+Ac DESIGN FLOW 360 gpd L.T.A.R. .025

Septic Tank	1000	Gallons: STB	1012	Date	4-10-08	☒ New System	☐ Repair	☐ Expansion System	Type I (II) III IV V VI
Pump Tank		Gallons: P T		Date		System Description:	Gravity 25% Reduction / Accepted		
Pump Make		Model		Serial #		Repair System Description:	SAME		
Nitrification Field	No Fields 1	No Lines 4	Linear Feet 360			Maintenance Agreement Required	☐ YES	☒ NO	
Trench Width	36"	Max. Trench Bottom Depth	36"*	Gravel Depth	NA	☒ GRAVITY	☐ PRESSURE		


☒ Residence	No. Bedrooms	3	Water Supply
☐ Business	No. Persons		☒ Private - NEW
☐ Other	No. Employees		☐ Public
☐ Slab	☐ Crawl Space		☐ Community
☒ Basement w/plumbing	☐ Basement w/o plumbing		

Comments / Conditions

36" max trench bottom on limited (not repair) discharge only.

Comments / Conditions

INITIAL SITE SKETCH

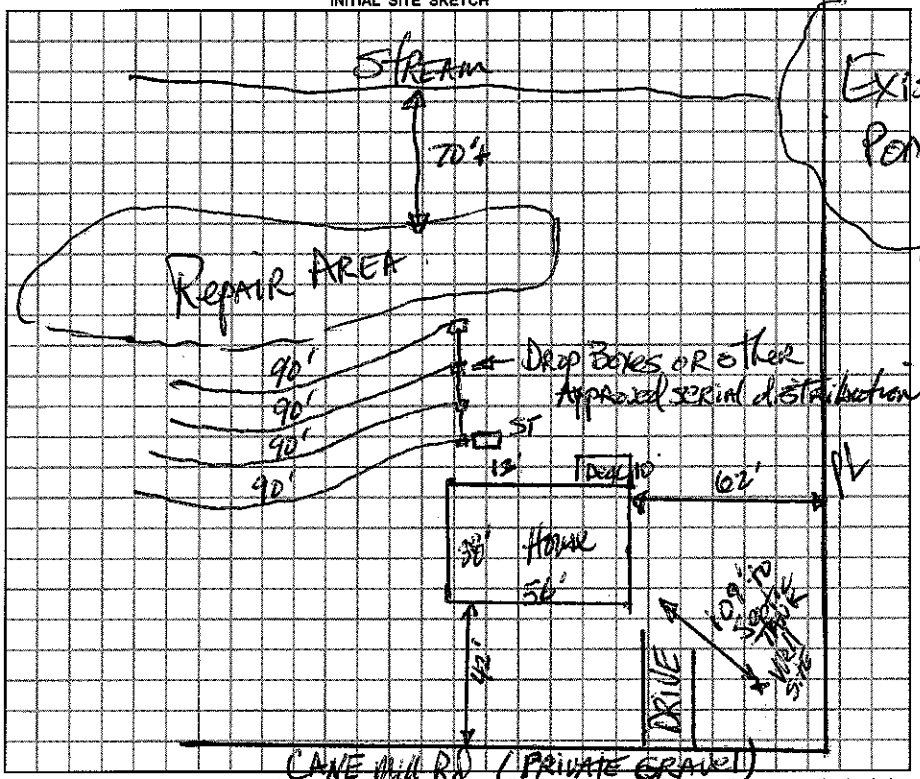

AS BUILT SKETCH

Permit can be suspended or revoked if any false information is supplied toward securing the permit / any unauthorized changes are made to the site / any unauthorized changes are made in the installation of the system.

☒ *IMPROVEMENT PERMIT w / plat valid without expiration* ☒ *IMPROVEMENT PERMIT w / site plan valid for 60 mos.* ☒ *AUTHORIZATION TO CONSTRUCT valid for period equal to IMPROVEMENT PERMIT-not to exceed 60 mo.*

Owner / Applicant Signature: Date 4-16-10

Improvement Permit by: Date 4-16-10

Authorization to Construct by: Date 4-16-10

Installed by: Gunner Grading

Operation Permit by: Date: 5-28-10

Existing System Inspected by: Date:

YOU SHOULD CONTACT A LOCATOR SERVICE PRIOR TO ANY EXCAVATION.

WHITE COPY Environmental Health YELLOW COPY (Final) Owner / Applicant PINK COPY (Initial) Owner / Applicant