IREDELL COUNTY HEALTH DEPARTMENT

STATESVILLE 704-878-5305 (C1) MOORESVILLE 704-664-5281

IMPROVEMENT PERMIT / AUTHORIZATION TO CONSTRUCT / OPERATION PERMIT / EXISTING SYSTEM INSPECTION

(C)

PERMIT# 136572 PIN# 4803-62-4660 591 DATE 6-24-06

OWNER OR APPLICANT NANCY & LAWRENCE AUSTIN PHONE: Business 704-876-1257x130 Home 704-592-5063

ADDRESS 925 LINNEY'S MILL ROAD, UNION GROVE, NC 28689

LOCATION NC 115 N, TL LINNEY'S MILL ROAD, 2ND DRIVE ON LEFT PAST COOLBROOK ROAD

SUBDIVISION _____ BLOCK / SECTION _____ LOT _____ LOT AREA 0.85 ACRE SITE CLASS PS DESIGN FLOW 360 L.T.A.R. 0.30 GPD/FT2

Septic Tank: 1000 Gallons; ST8 854 Date 7-21-06

Pump Tank: _____ Gallons; PT _____ Date _____

Pump Make: _____ Model _____ Serial No. _____

Nitrification Field: No Fields I Square Feet EQ. TO 1200 Linear Feet 300

No Lines SIX Trench Width 36" Max Trench Bottom Depth 36"

☑ New System ☐ Repair ☐ Expansion System Type: I (II) III IV V VI

System Description: 25% REDUCTION, GRAVITY

Repair System Description: 25% REDUCTION, GRAVITY

Maintenance Agreement Required: ☐ Yes ☑ No

☑ House/Mod. Home No. Bedrooms 3

☐ Mobile Home No. Persons _____

☐ Business No. Employees _____


☐ Other _____

Water Supply: ☑ Individual ☐ Public ☐ Community WELL

Gravel Depth N/A ☑ Gravity ☐ Pressure ☐ Slab ☑ Crawl Space ☐ Basement w/plumbing ☐ Basement wo/plumbing


Comments/Conditions: (1) EXISTING OUTBUILDINGS & HOUSE TO BE REMOVED (2) INSTALL 25% REDUCTION SYSTEM AS FLAGGED NO DEEPER THAN 36" ON CONTOUR (3) KEEP SYSTEM MINIMUM 15' FROM HOUSE, 10' FROM PROPERTY LINE.

INITIAL SITE SKETCH

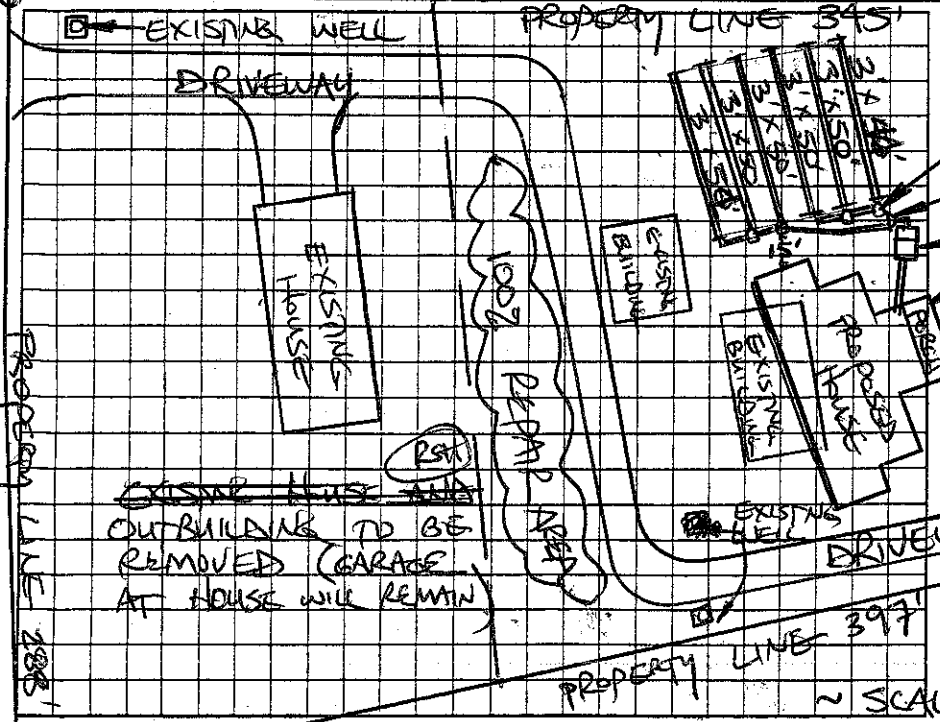

Comments/Conditions: SEE ATTACHED PLAT FOR NEW PROPERTY LINE. SEPTIC TANK WITH MARKER INSTALLED USING "ZABEL" FILTER

AS BUILT SKETCH

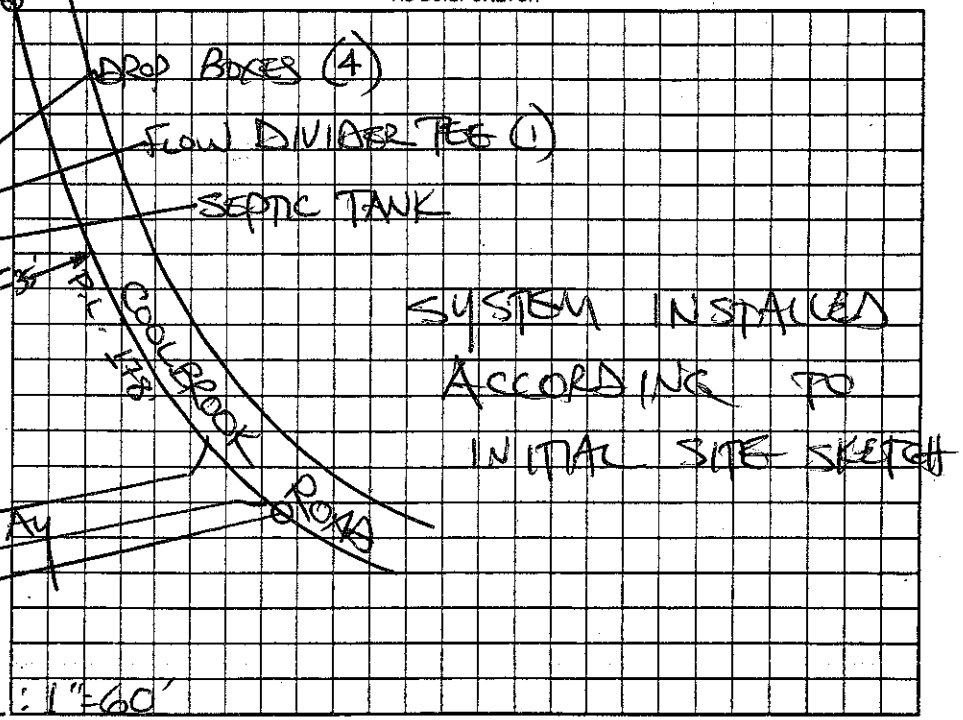

LINNEY'S MILL ROAD

Permit can be suspended or revoked if any false information is supplied toward securing the permit/any unauthorized changes are made to the site/any unauthorized changes are made in the installation of the system. Improvement Permit with plat valid without expiration ☐ Improvement Permit with site plan valid for sixty months ☑ Authorization to Construct is valid for a period equal to that of Improvement Permit – not to exceed sixty months.

Signed: _____ date 6/24/06 Installed by: MINTON'S BACKHOE SERVICE

Improvement Permit by: STEVE HEDRICK date 6-24-06 Operation Permit by: STEVE HEDRICK date 9-12-06

Authorization to Construct by: STEVE HEDRICK date 6-24-06 Existing System Inspection by: _____ date _____

HEALTH DEPT. COPY: WHITE OWNER COPY (FINAL): YELLOW OWNER COPY (INITIAL): PINK