PERMIT # 159150 PIN # 4803-73-1103

IREDELL COUNTY HEALTH DEPARTMENT – *Environmental Health Division*

Statesville Office 704-878-5305 Mooresville Office 704-660-3625

PRIVATE DRINKING WATER WELL PERMIT

Type of Permit (circle one) (New) Repair Abandonment

APPLICANT INFORMATION

Central Volunteer Fire Dept. 4634 Wilkesboro Hwy Statesville (704) 902-3598

Name Full Address Telephone #

PROPERTY INFORMATION


115N TL Linney's Mill Rd. ON Rt. Corner of Barkers Grove Rd.

Directions to Site

117 Barkers Grove Rd. Union Grove

Physical location of proposed well (street address) Subdivision Lot #

Initial Site Sketch

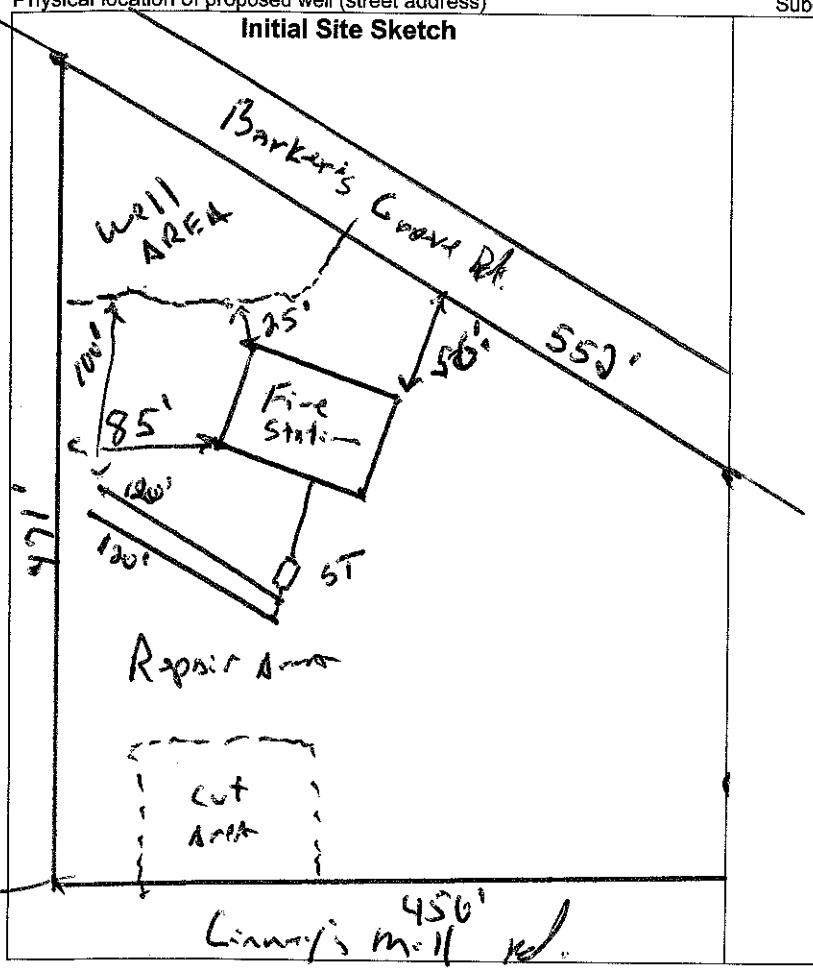

"As Built" Sketch

Permit Conditions/ Comments: Keep 100' from septic system. / Keep 25' from all building foundations

Well Permit Issued By: [signature] R.S. **Date:** 16 April 10

(Permit is valid for 5 years from date issued. This permit may be revoked if it is determined there has been a material change in any fact or circumstance upon which the permit is issued. Actions of the employees of the Iredell County Health Department shall in no way be taken as a guarantee that this well will produce water of any particular quantity or quality or for any amount of time. Employees of the Iredell County Health Department assume no liability for any damages, either direct or consequential which may be caused by this well.)

Well GPS Coordinates Lat: 36° 01.378 **Long:** 81° 00.306 **Well Contractor** Air Drill **Contractor Cert #** 2901

Grout Inspection By: [signature] R.S **Date:** 25 May 10 **or Certification for Grouting Not Witnessed by Dept** **Date:**

Well Head Inspection (check when completed) Grout to Ground Surface ☑

Well Contractor ID Plate ☑ Pump Installer ID Plate ☑ Sample Port ☑ Access Port / Vent ☑ Well Seal ☑ Well Head 12 inches ☑

Pit less Adaptor 8 inches above grade ☑ **Well Head Inspection By:** [signature] RS **Date:** 25 Feb. 11

Certificate of Completion by: [signature] **Date:** 25 Feb. 11 **Water Samples By:** [signature] **Date:** 5-3-11

Attachments: Form GW-1a (***required except for abandonment***) ☑ Form GW 30 ☐ Water Sample Results ☑ Plat ☐

Health Dept. Copy - White Applicant Certificate of Completion - Yellow Applicant Well Construction Permit - Pink