addl pool 8/09

IREDELL COUNTY HEALTH DEPARTMENT

STATESVILLE 704-878-5305 (cl) MOORESVILLE 704-664-5281 (cl)

IMPROVEMENT PERMIT / AUTHORIZATION TO CONSTRUCT / OPERATION PERMIT / EXISTING SYSTEM INSPECTION

PERMIT # 153377 PIN # 4863-73-4720 DATE 25 November 08

OWNER or APPLICANT David & Ann Marie Rolando PHONE: Business 603-986-5781 Home:

OWNER or APPLICANT ADDRESS PO Box 2428 PMB 11968 Pensacola, FL.

LOCATION / DIRECTIONS Hwy 115N TL Livengs mill rd. TR Parkers Grove - on Rt.

SUBDIVISION Brushy Mtn Acres BLOCK / SECTION LOT # 10 LOT AREA 8.41Ac. DESIGN FLOW 480 gpd L.T.A.R. 0.3 gpd/ft²

Septic Tank 1000 Gallons: STB 1012 Date 9-5-08

Pump Tank Gallons: P T Date

Pump Make Model Serial #

Nitrification Field No Fields 1 No Lines 4 Linear Feet 100'

Trench Width 36" Max. Trench Bottom Depth 36" Gravel Depth N/A

☑ New System ☐ Repair ☐ Expansion System Type I II (III) IV V VI

System Description: 25% Reduction

Repair System Description: 25% Reduction

Maintenance Agreement Required ☐ YES ☑ NO

☑ GRAVITY ☐ PRESSURE

☑ Residence No. Bedrooms 4

☐ Business No. Persons

☐ Other No. Employees

☐ Slab ☐ Crawl Space

☑ Basement w/plumbing ☐ Basement w/o plumbing

Water Supply: ☑ Private ☐ Public ☐ Community

Comments / Conditions: Follow contour

Comments / Conditions

INITIAL SITE SKETCH

Please see Attached Site sketch.

AS BUILT SKETCH

Location of the proposed 32'x37.5' ACCESSORY BLDG. addition does not appear to impact the existing on-site septic system.**NOTE: SEE ATTACHED SITE SKETCH

R. STEVE HEDRICK REHS

Date: 10 - 1 - 2012

ICHD-Environmental Health Division

Permit can be suspended or revoked if any false information is supplied toward securing the permit / any unauthorized changes are made to the site / any unauthorized changes are made in the installation of the system.

☐ *IMPROVEMENT PERMIT w / plat valid without expiration* ☑ *IMPROVEMENT PERMIT w / site plan valid for 60 mos.* ☑ *AUTHORIZATION TO CONSTRUCT valid for period equal to IMPROVEMENT PERMIT-not to exceed 60 mo.*

Owner / Applicant Signature: David P Rolando Date 25 Nov 08

Improvement Permit by: R.S. Date 25 Nov. 08

Authorization to Construct by: R.S. Date 25 Nov. 08

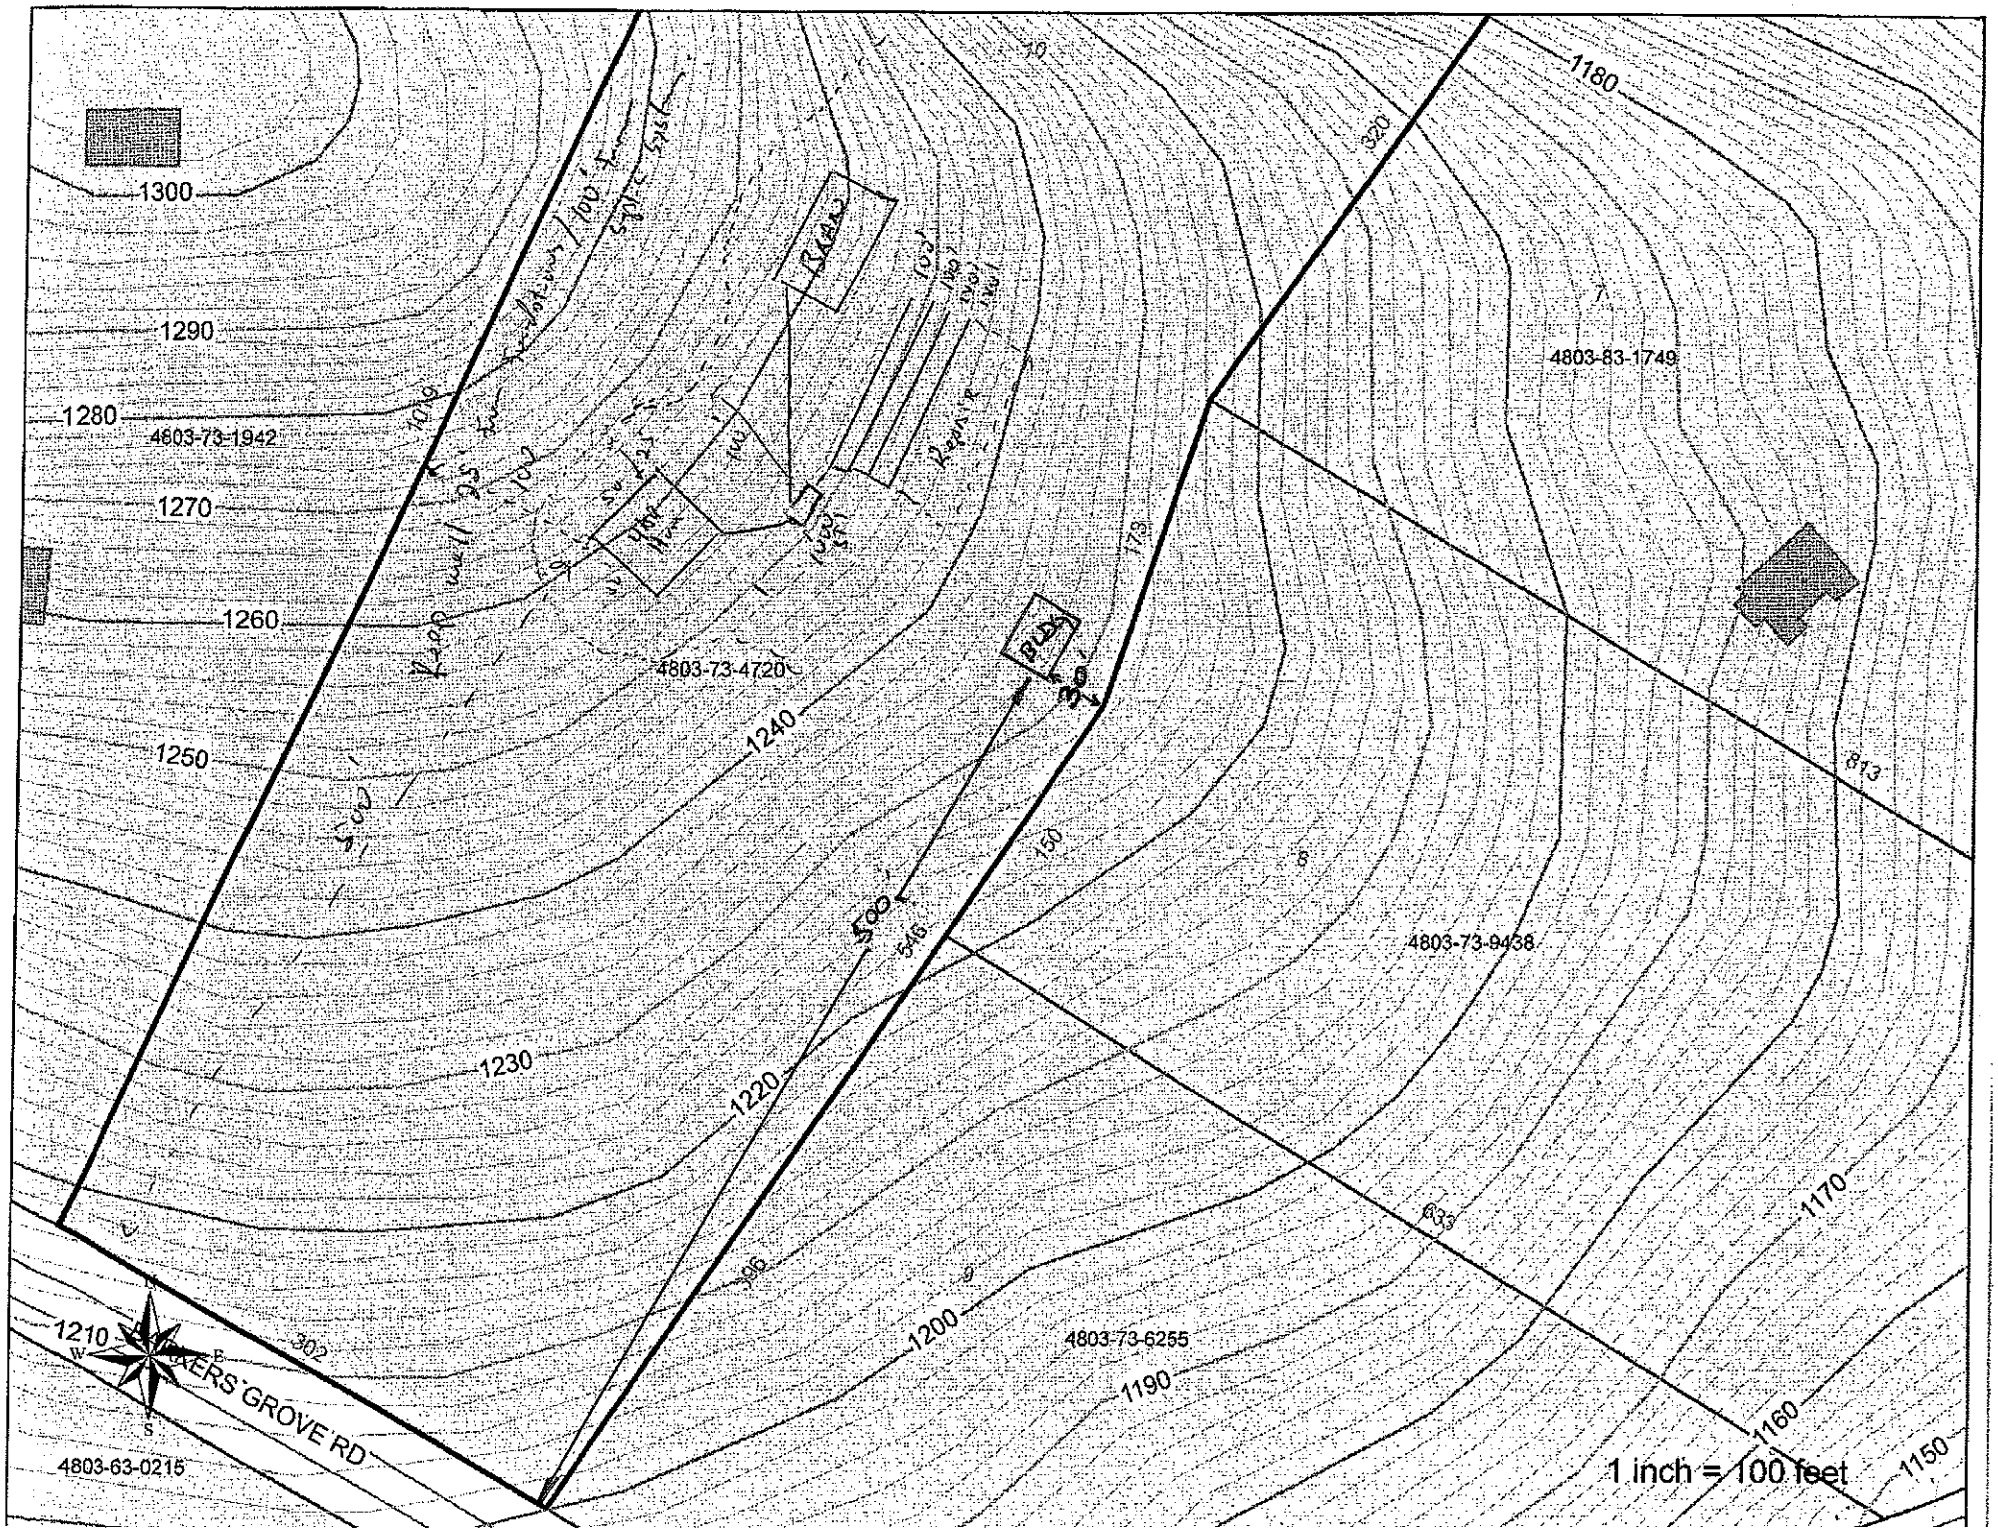
YOU SHOULD CONTACT A LOCATOR SERVICE PRIOR TO ANY EXCAVATION.

Installed by: C&C

Operation Permit by: Date: 4-7-9

Existing System Inspected by: Date:

WHITE COPY Environmental Health YELLOW COPY (Final) Owner / Applicant PINK COPY (Initial) Owner / Applicant


1300
1290
1280
1270
1260
1250
1240
1230
1220
1210
1200
1190
1180
1170
1160
1150
4803-73-1942
4803-73-4720
4803-63-1749
4803-73-9438
4803-73-6255
4803-63-0215
EXERS GROVE RD
1 inch = 100 feet